


MINNESOTA CENTER


Suite 350

As-Built

3,983 Sq. Ft.

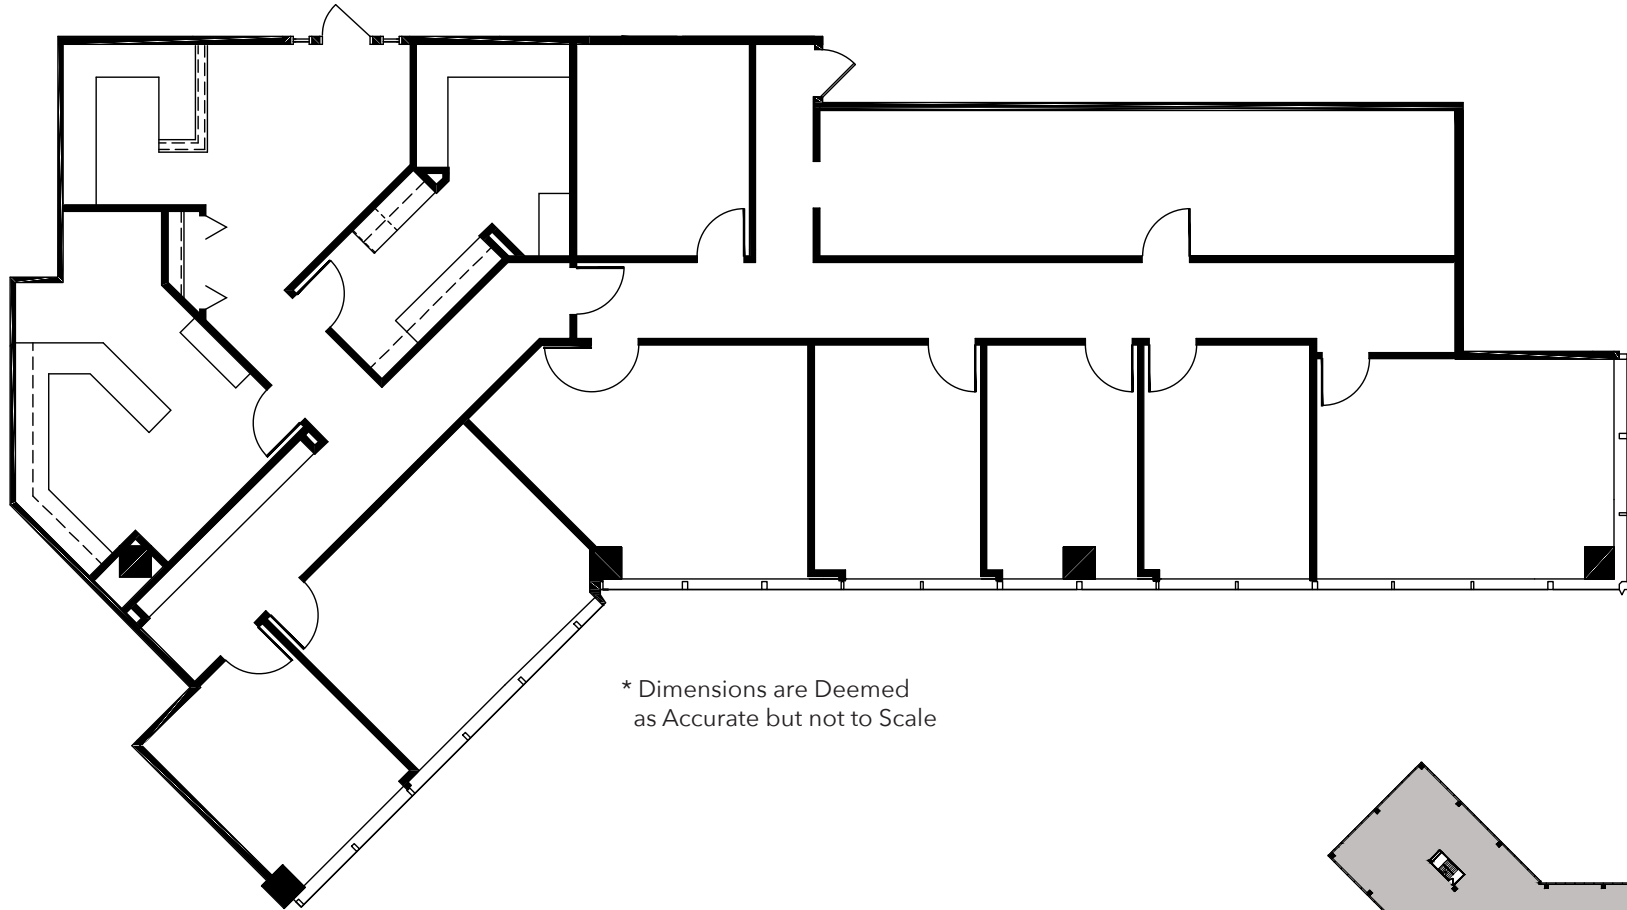

* Dimensions are Deemed
as Accurate but not to Scale

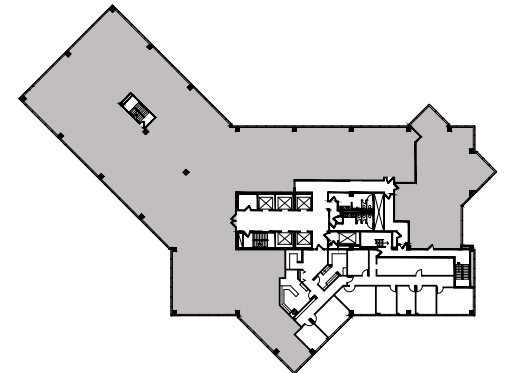

OWNED & MANAGED BY



LEASED BY

