



Suite 360

As-Built 2,870 Sq. Ft.

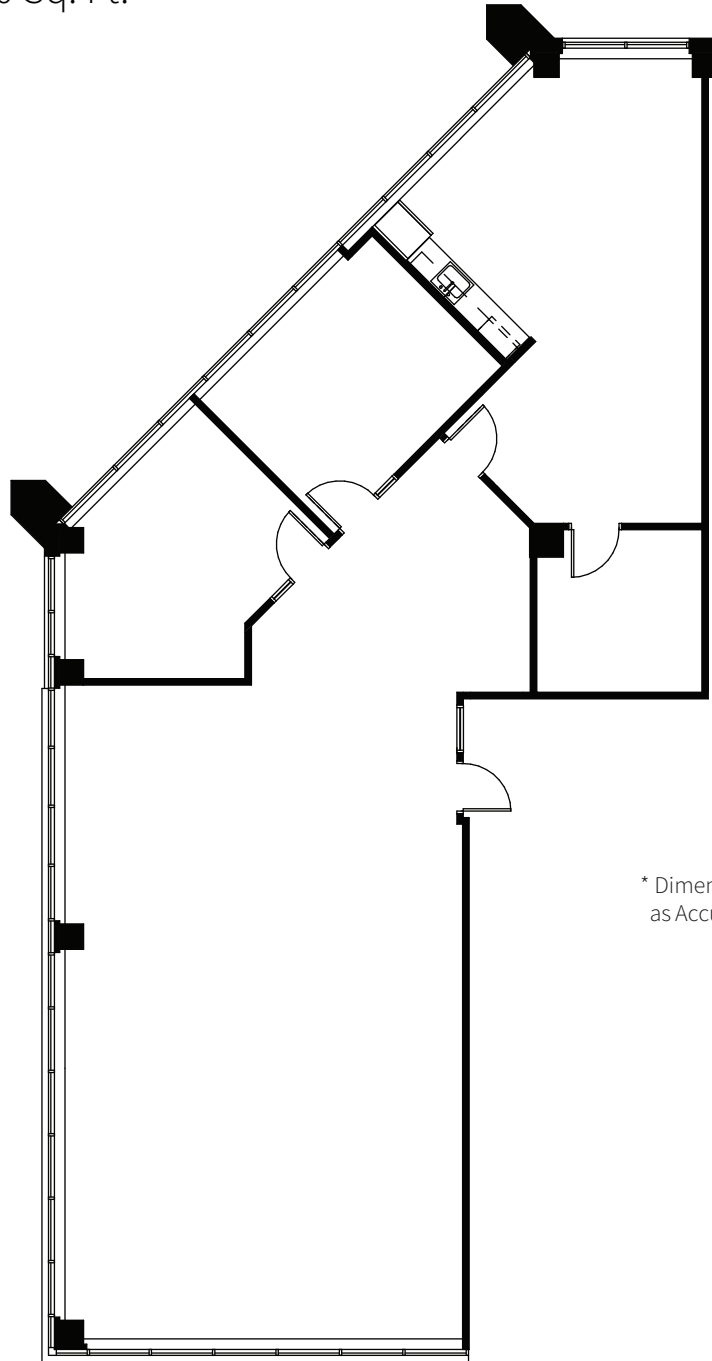

* Dimensions are Deemed as Accurate but not to Scale

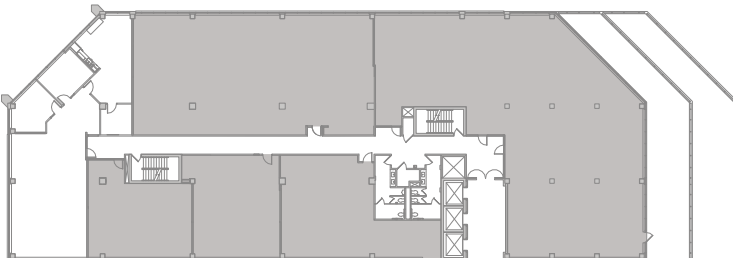

OWNED & MANAGED BY



LEASED BY

