




# FLAGSHIP


corporate center

Suite 380

As-Built      5,557 Sq. Ft.

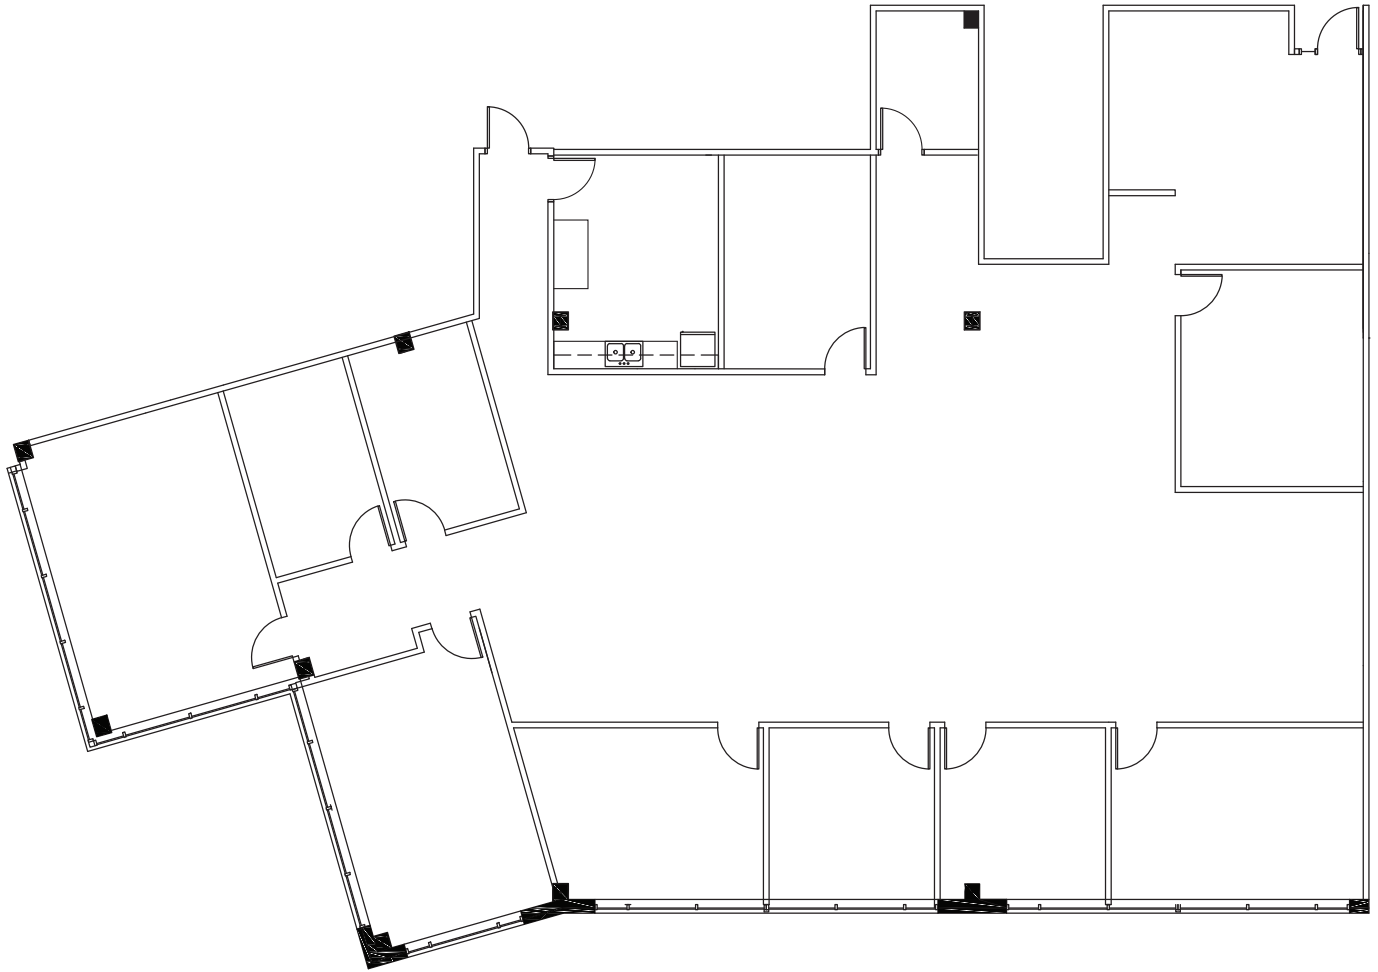

*\* Dimensions are Deemed  
as Accurate but not to Scale*

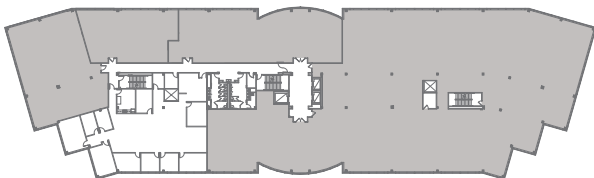

OWNED & MANAGED BY



LEASED BY

