



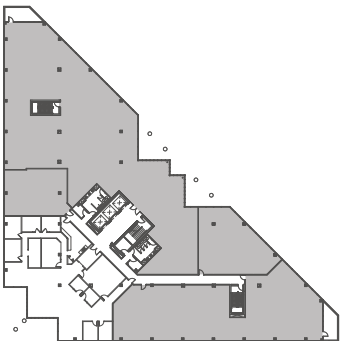

# BROADWAY WEST

Suite 3850

As-Built      5,285 Sq. Ft.

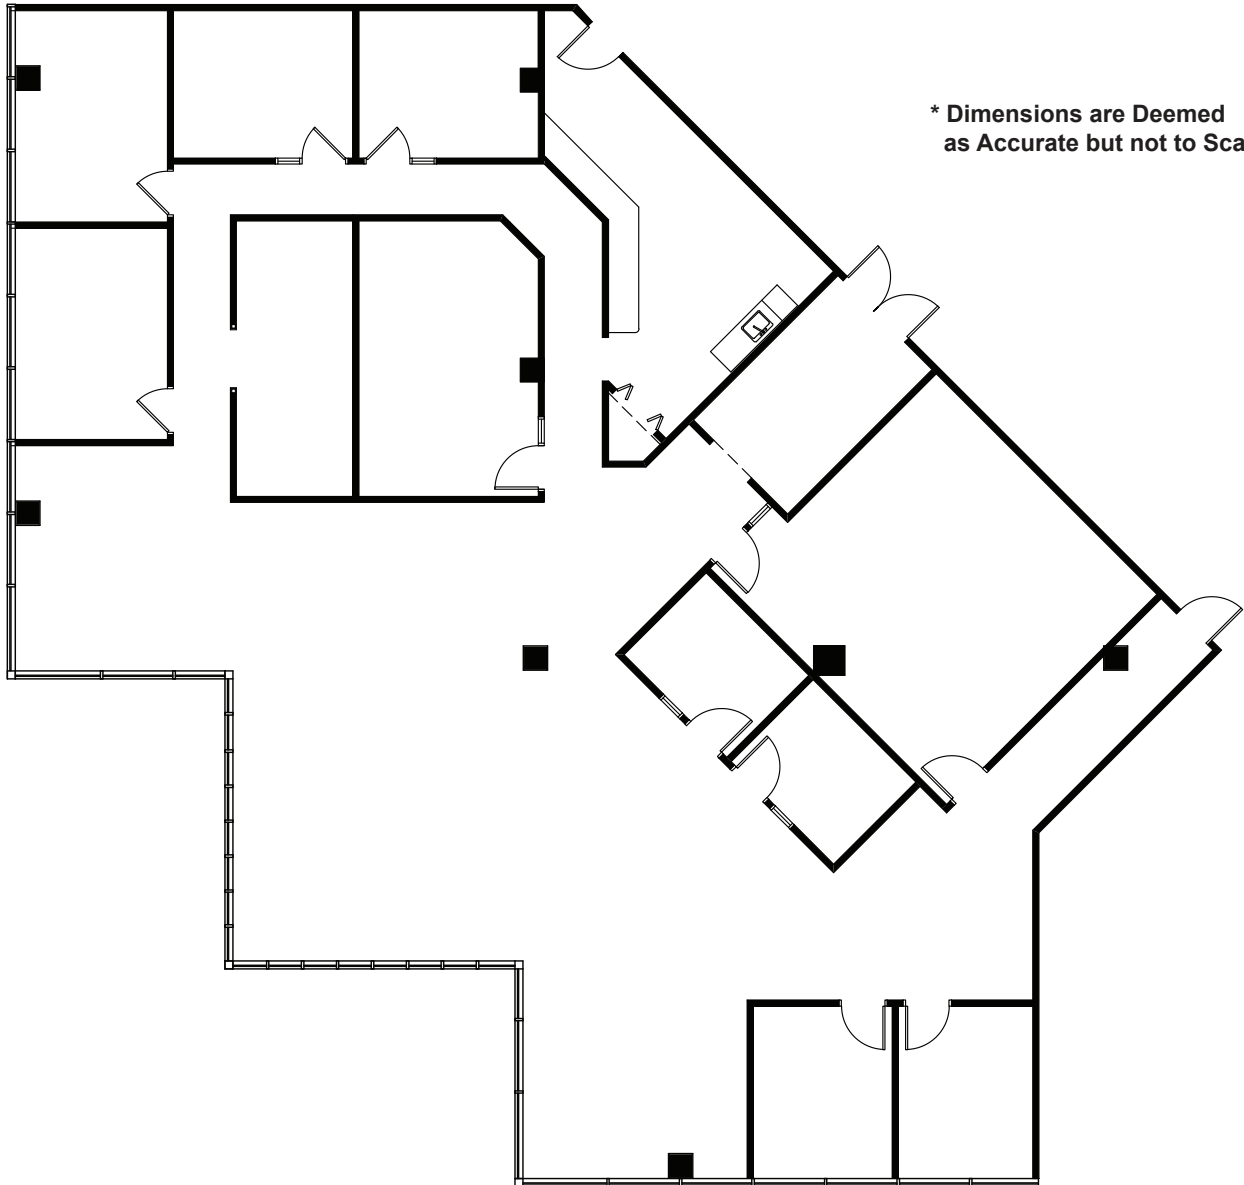

OWNED & MANAGED BY



LEASED BY

