


 BEMISTON TOWER

Suite 400

As-Built

13,970 Sq. Ft.

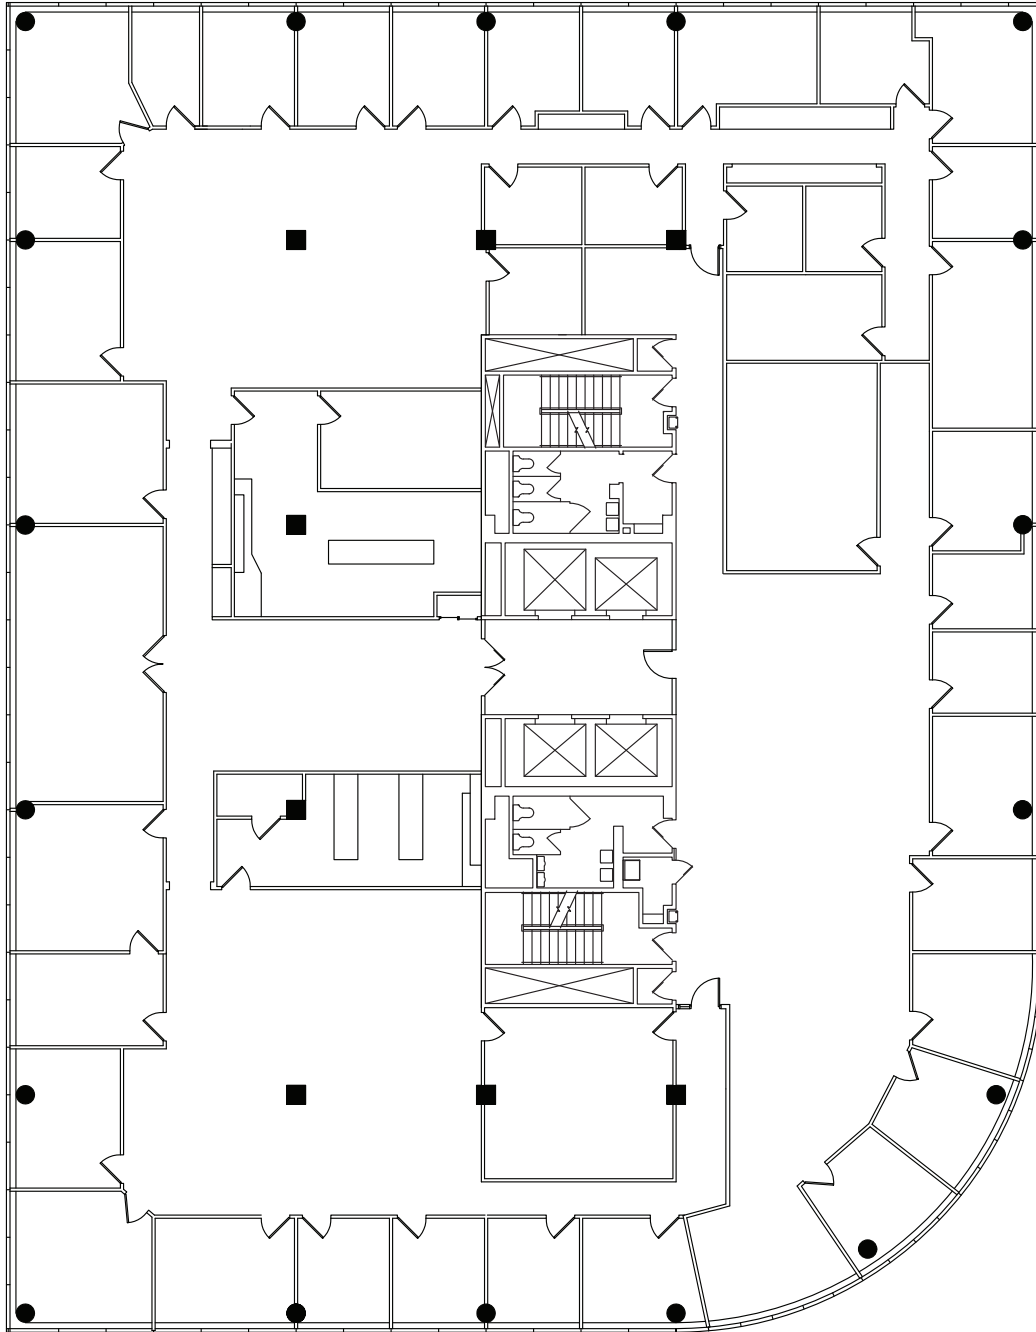

* Dimensions are Deemed as Accurate but not to Scale

LEASED & MANAGED BY

