


EDINBURGH


CORPORATE CENTER

Suite 412

As-Built 4,799 Sq. Ft.

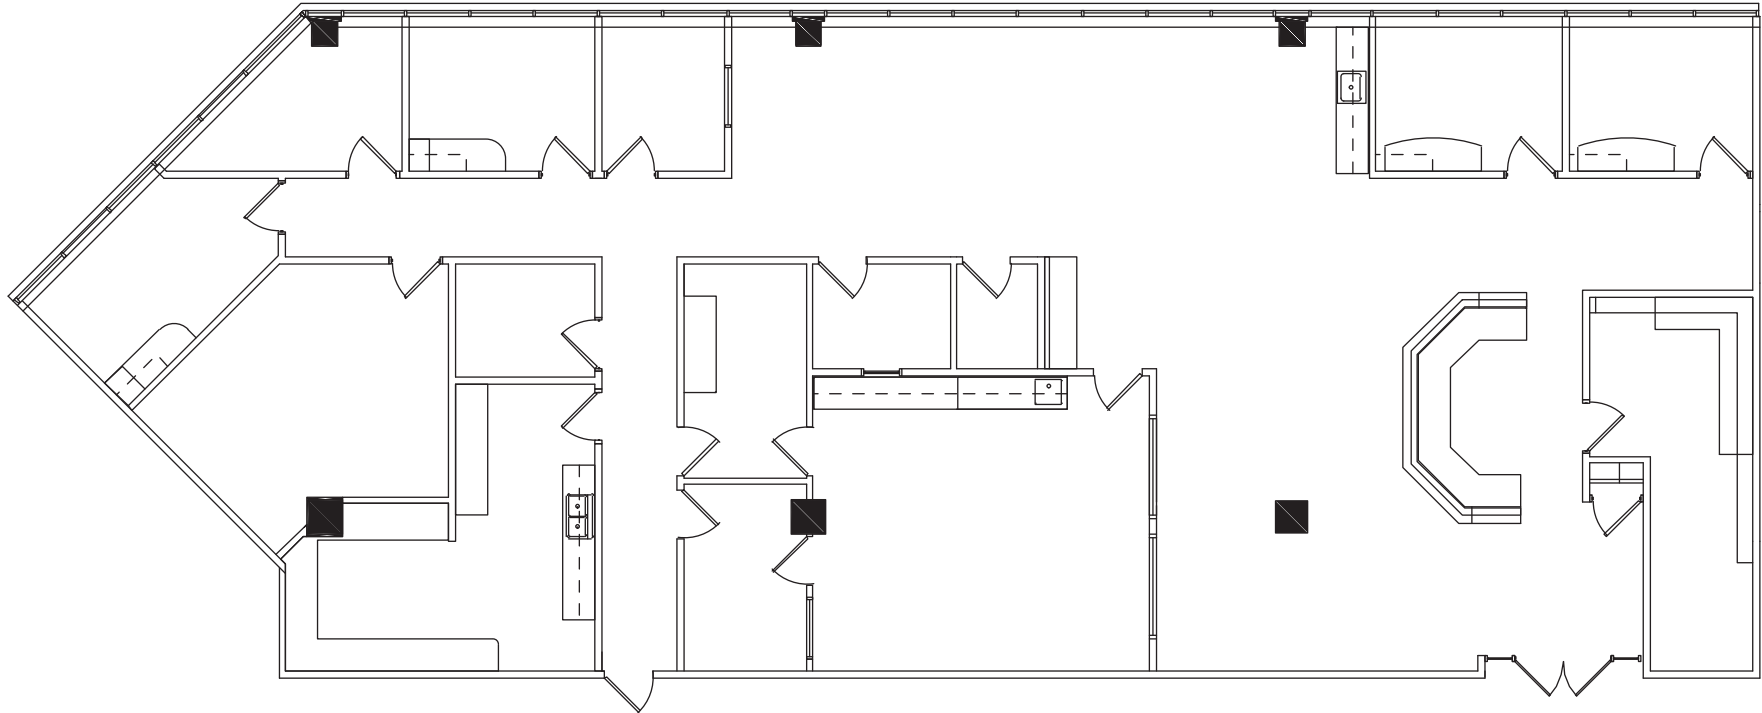

* Dimensions are Deemed as Accurate but not to Scale

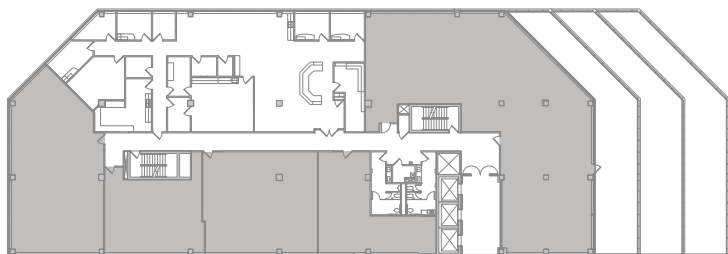

OWNED & MANAGED BY



LEASED BY

