


# CIBC PLACE

Suite 415

As-Built 1,519 Sq. Ft.

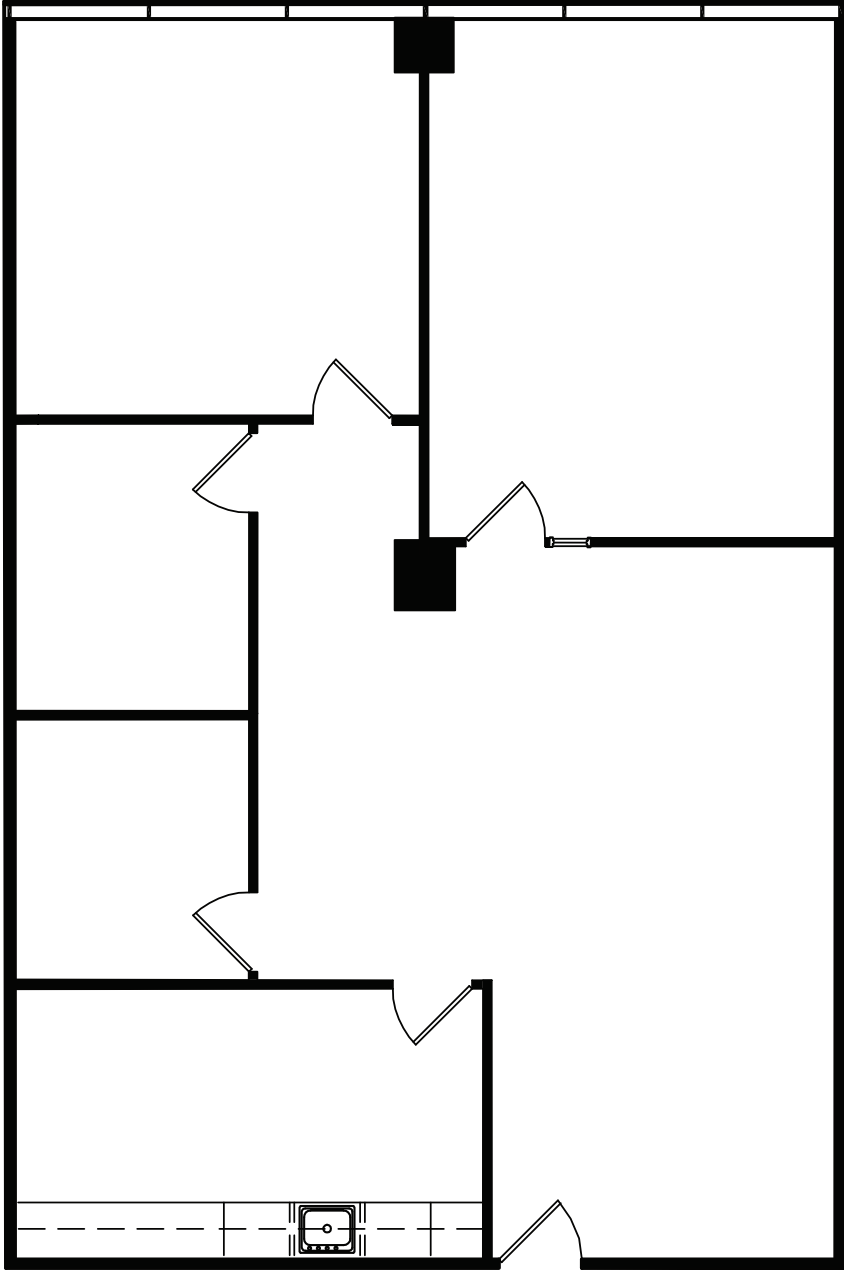

\* Dimensions are Deemed as Accurate but not to Scale

