
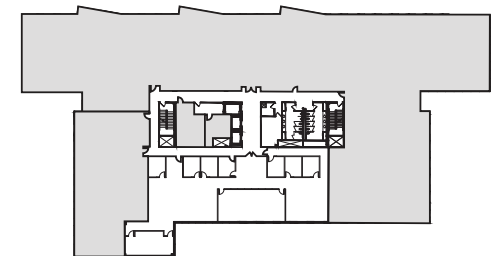


## Suite 420

As-Built

5,744 Sq. Ft.

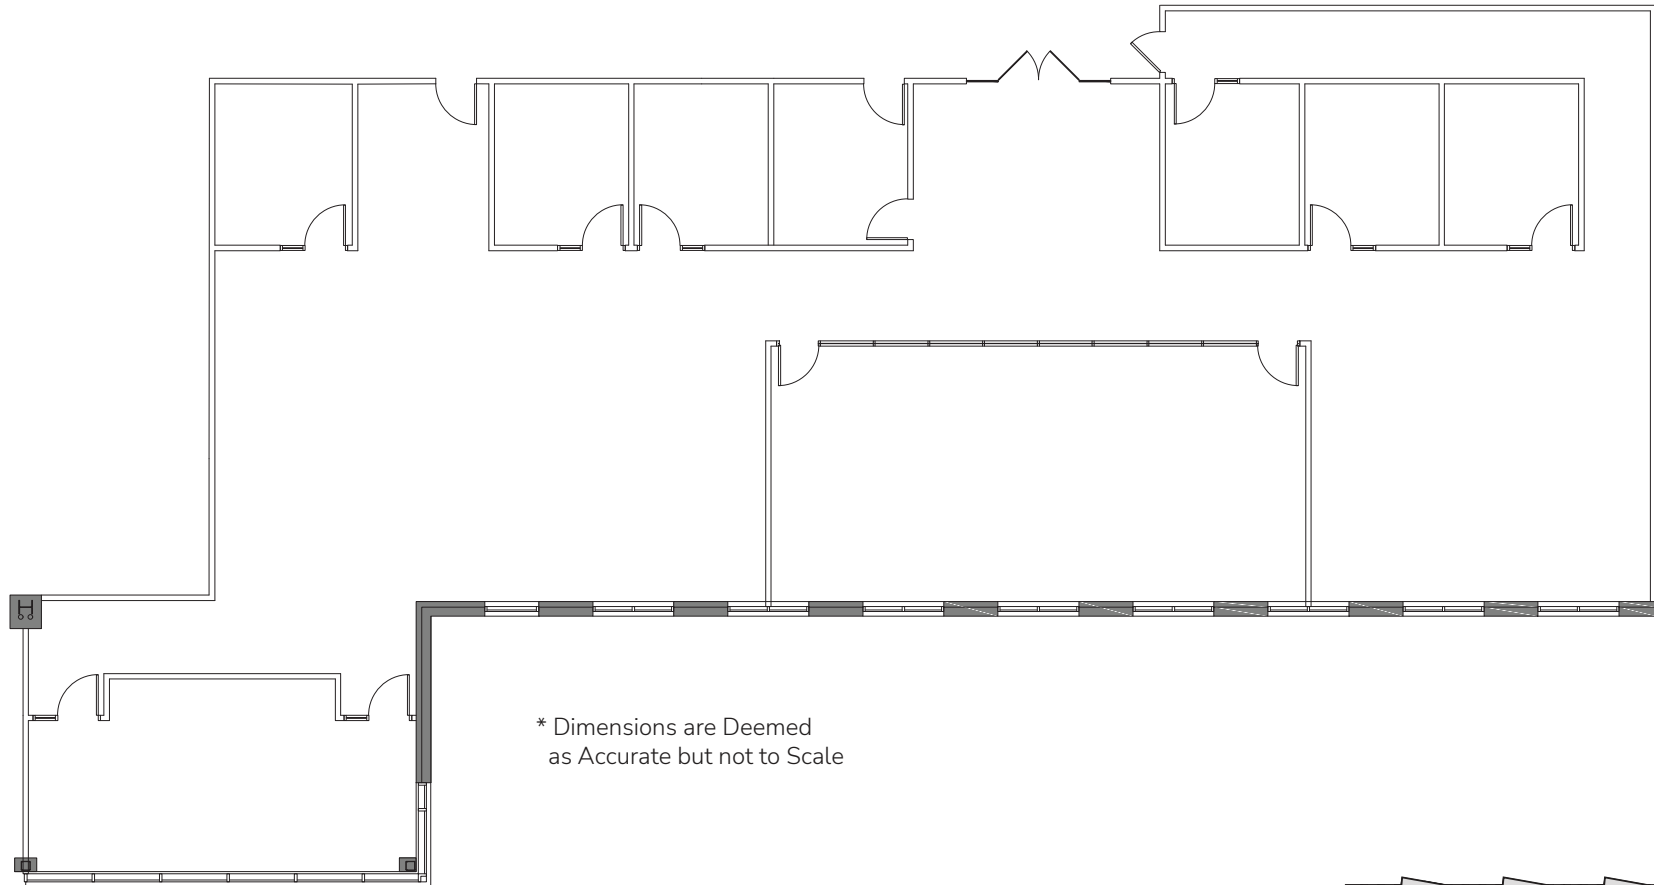

OWNED & MANAGED BY



LEASED BY

