



Suite 420

As-Built 5,744 Sq. Ft.

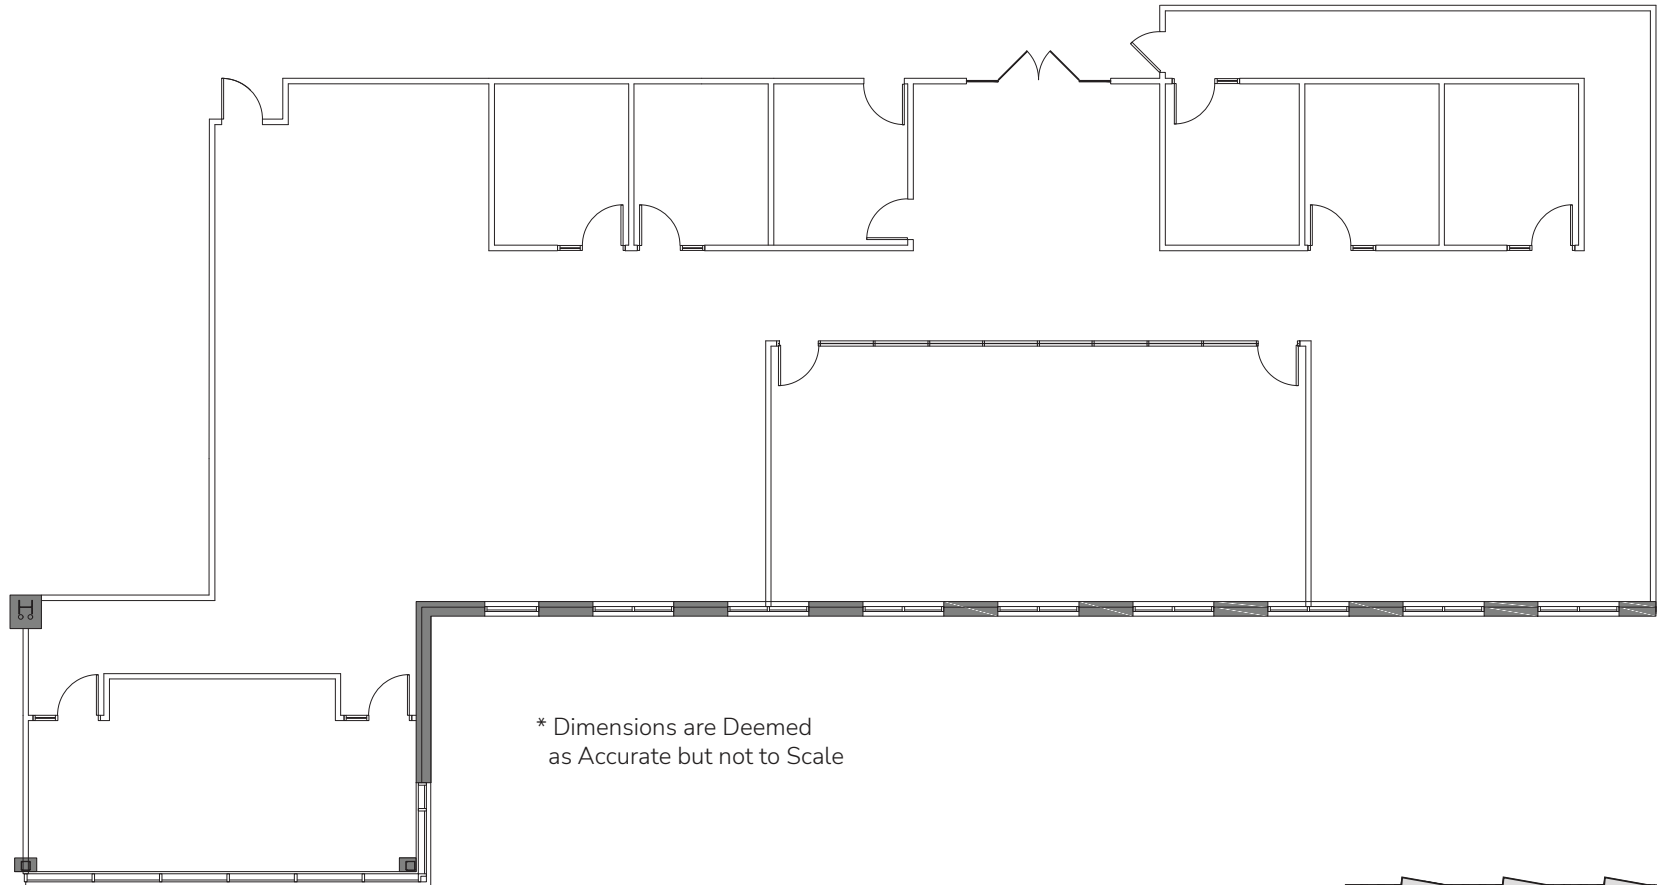

* Dimensions are Deemed
as Accurate but not to Scale

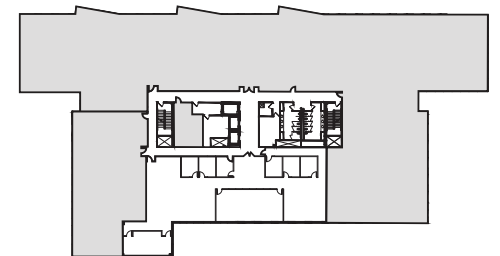

OWNED & MANAGED BY



LEASED BY

