


**HIGHLANDS ONE @ FOREST PARK** 

## Suite 450

As-Built 10,557 Sq. Ft.

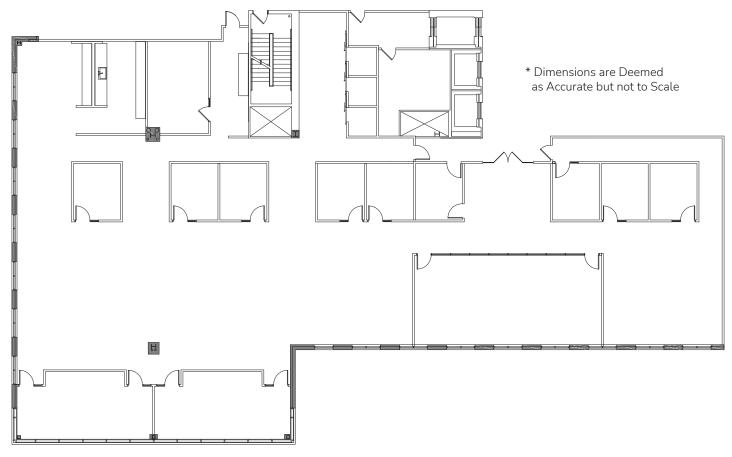

LEASED BY

**OWNED & MANAGED BY** 





