


Suite 450

As-Built 1,184 Sq. Ft.



* Dimensions are Deemed as Accurate but not to Scale

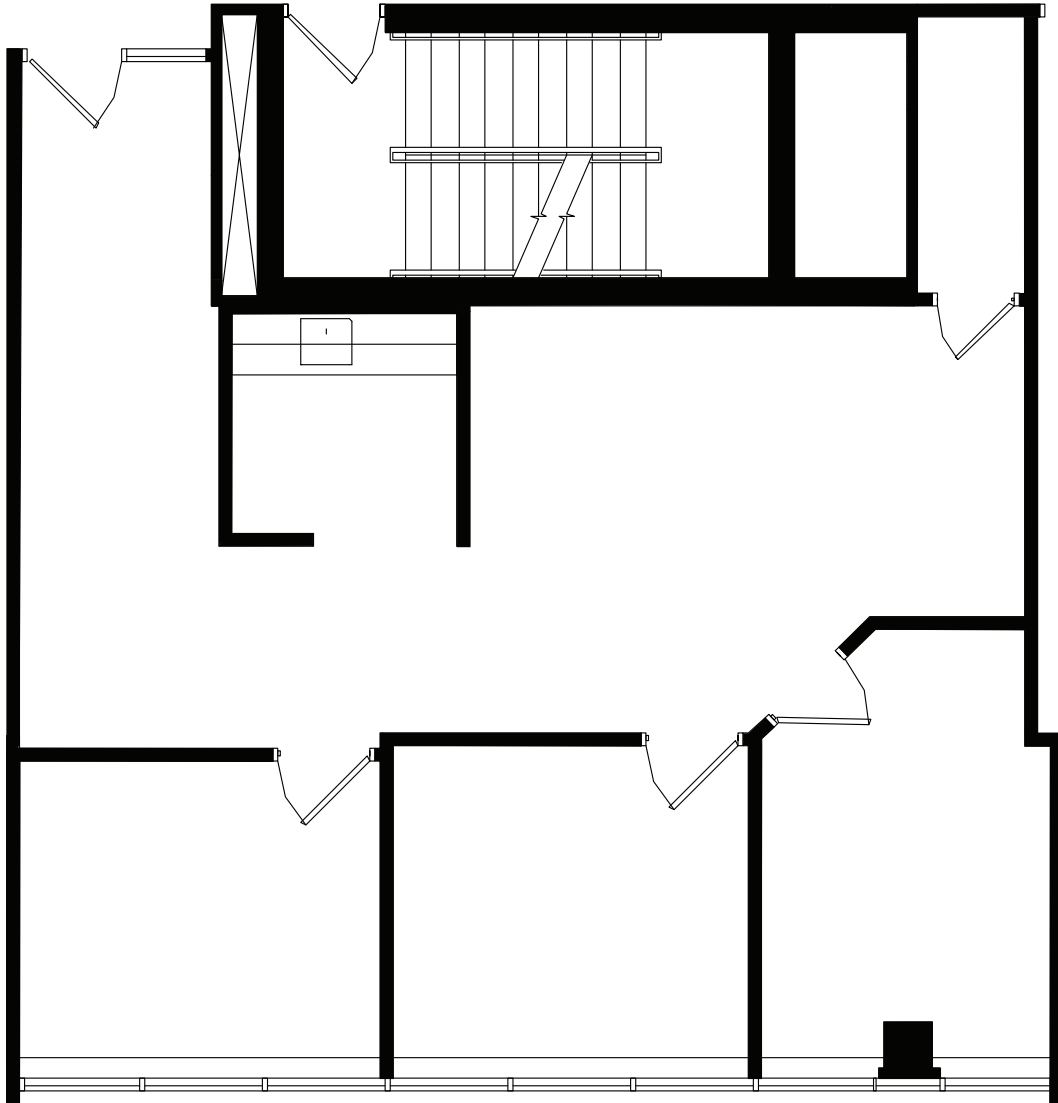