
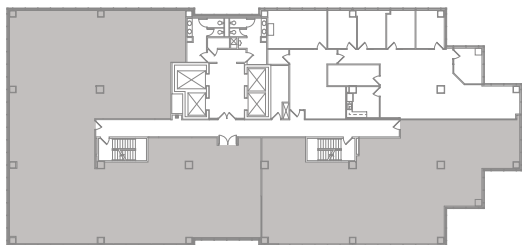


OLYMPIC PLACE

Suite 450

As-Built 3,080 Sq. Ft.

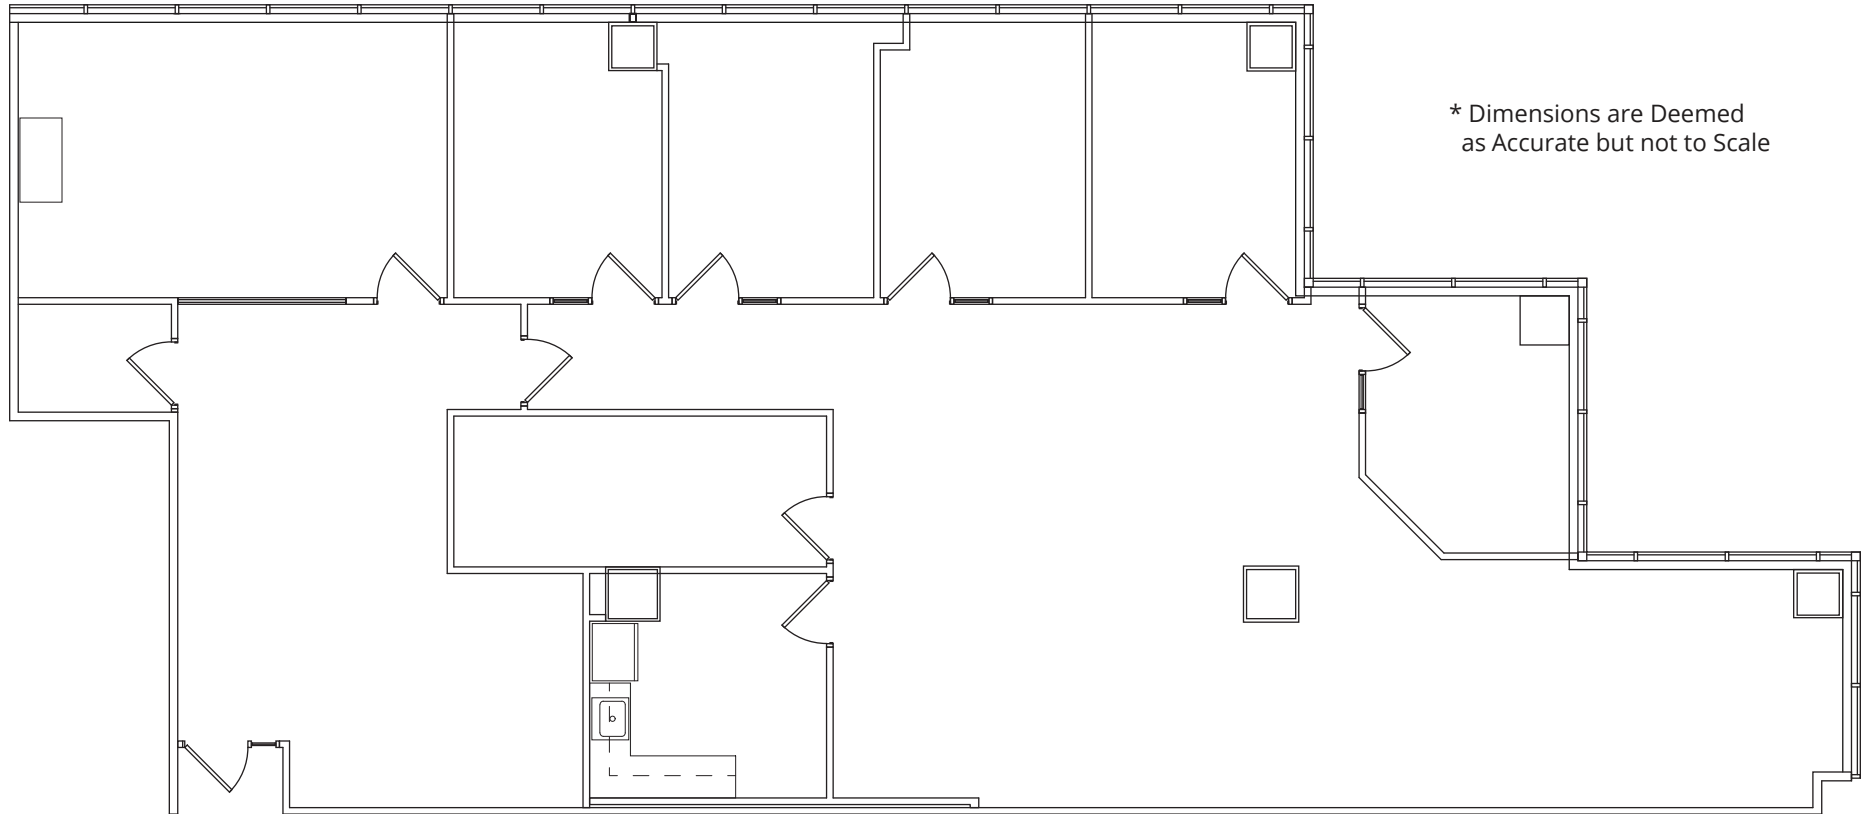

OWNED & MANAGED BY



LEASED BY

