
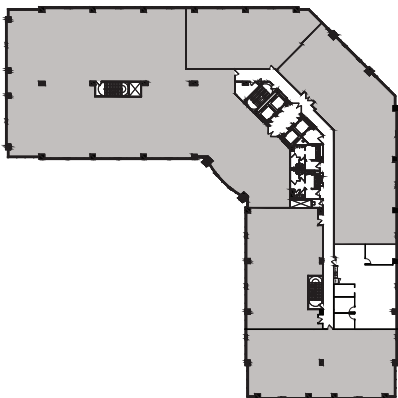


Suite 460

As-Built

2,147 Sq. Ft.

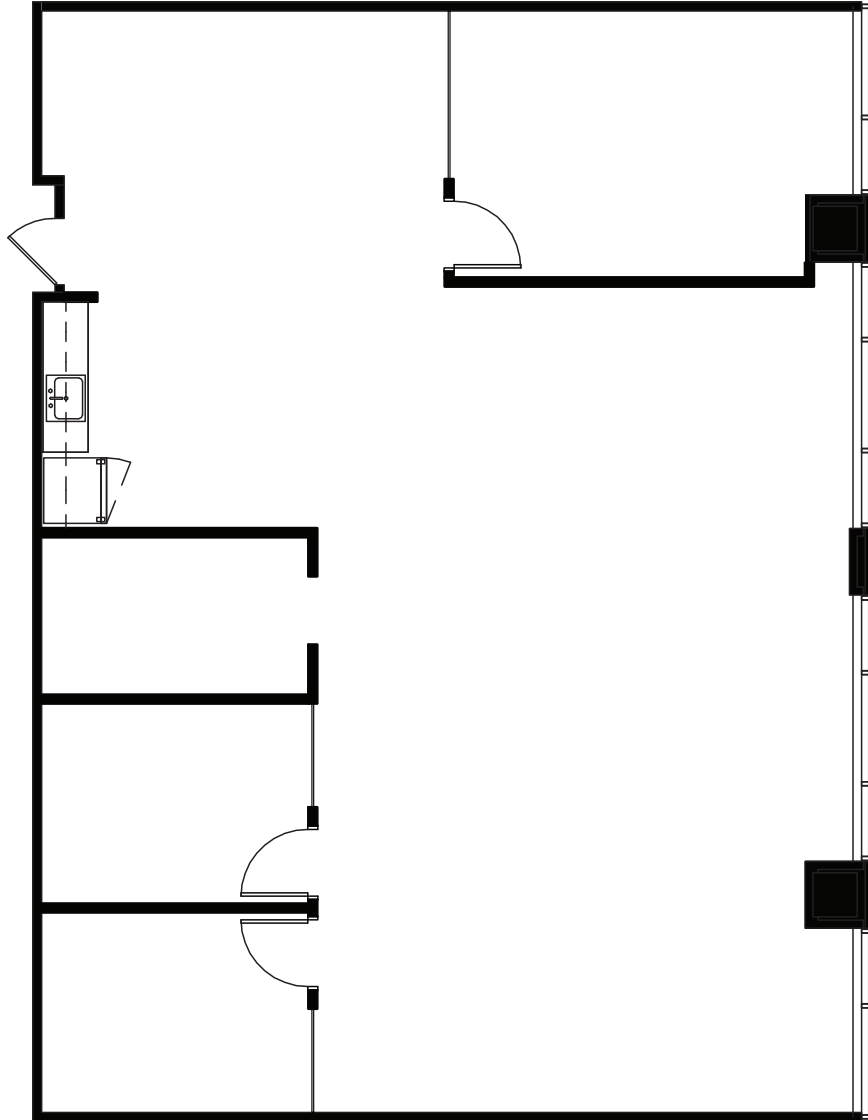

* Dimensions are Deemed as Accurate but not to Scale

OWNED & MANAGED BY



LEASED BY

