




METROPOLITAN FLATS

4651 Forest Park Avenue

As-Built 5,477 Sq. Ft.

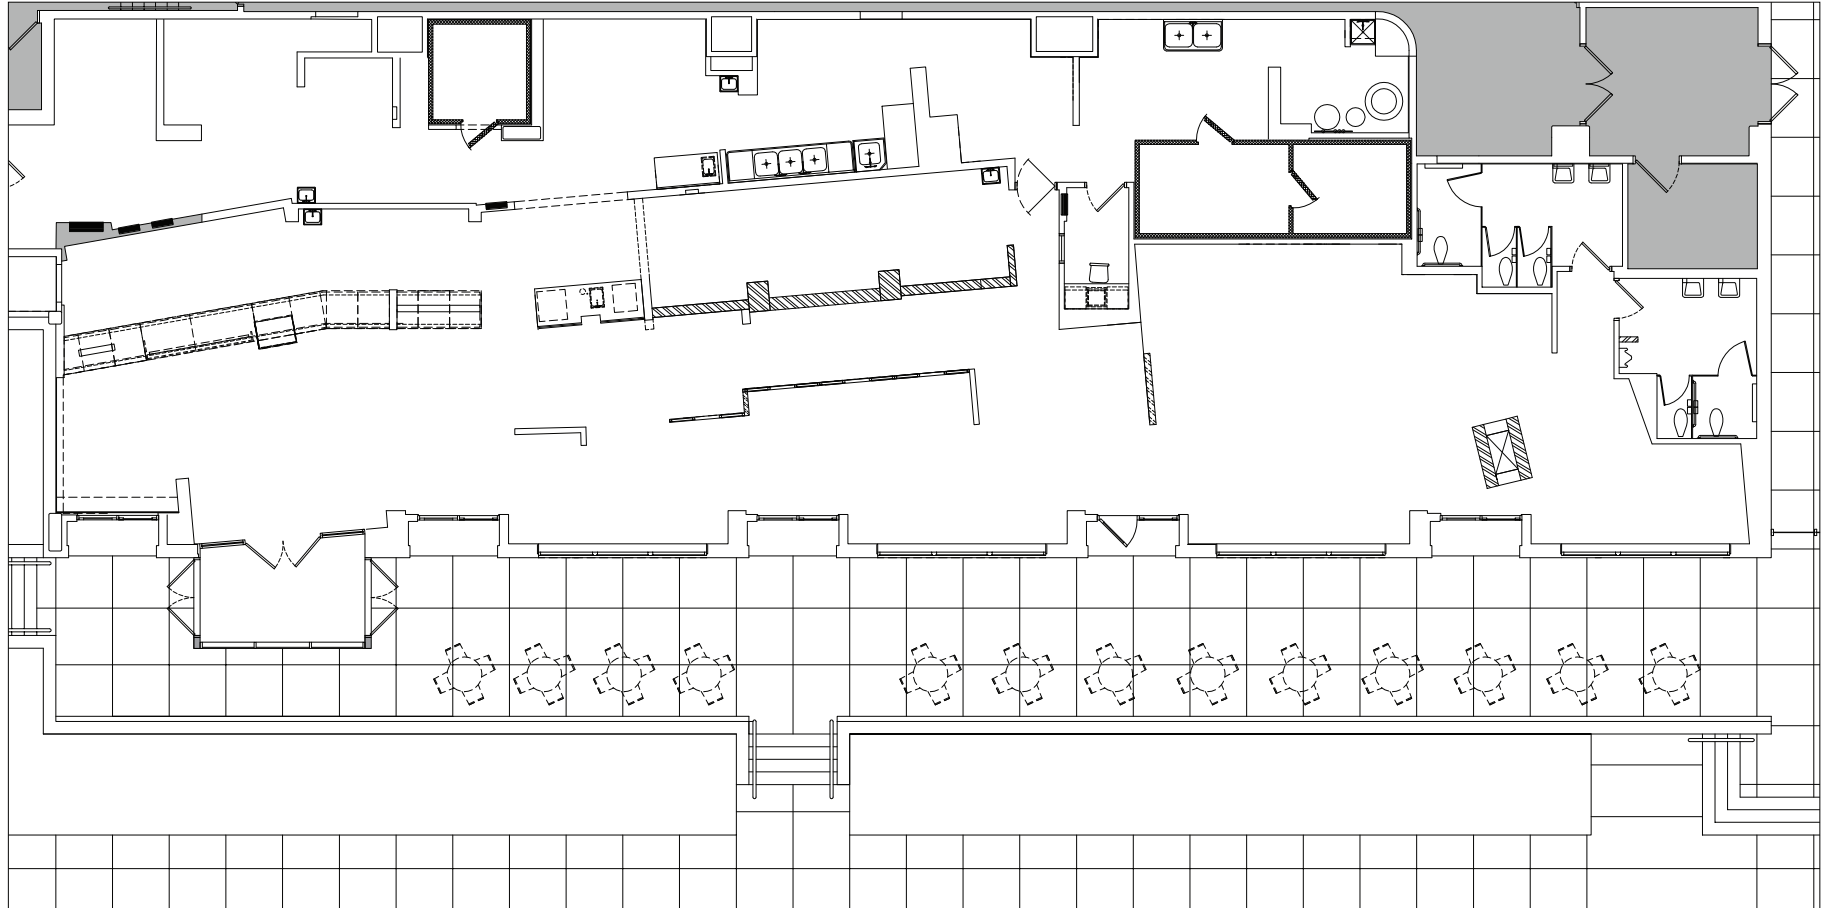

* Dimensions are Deemed
as Accurate but not to Scale

LEASED BY

CBRE

MANOR REAL ESTATE

OWNED BY

 **ALTUS**