




METROPOLITAN FLATS

4651 Forest Park Avenue

As-Built 5,477 Sq. Ft.

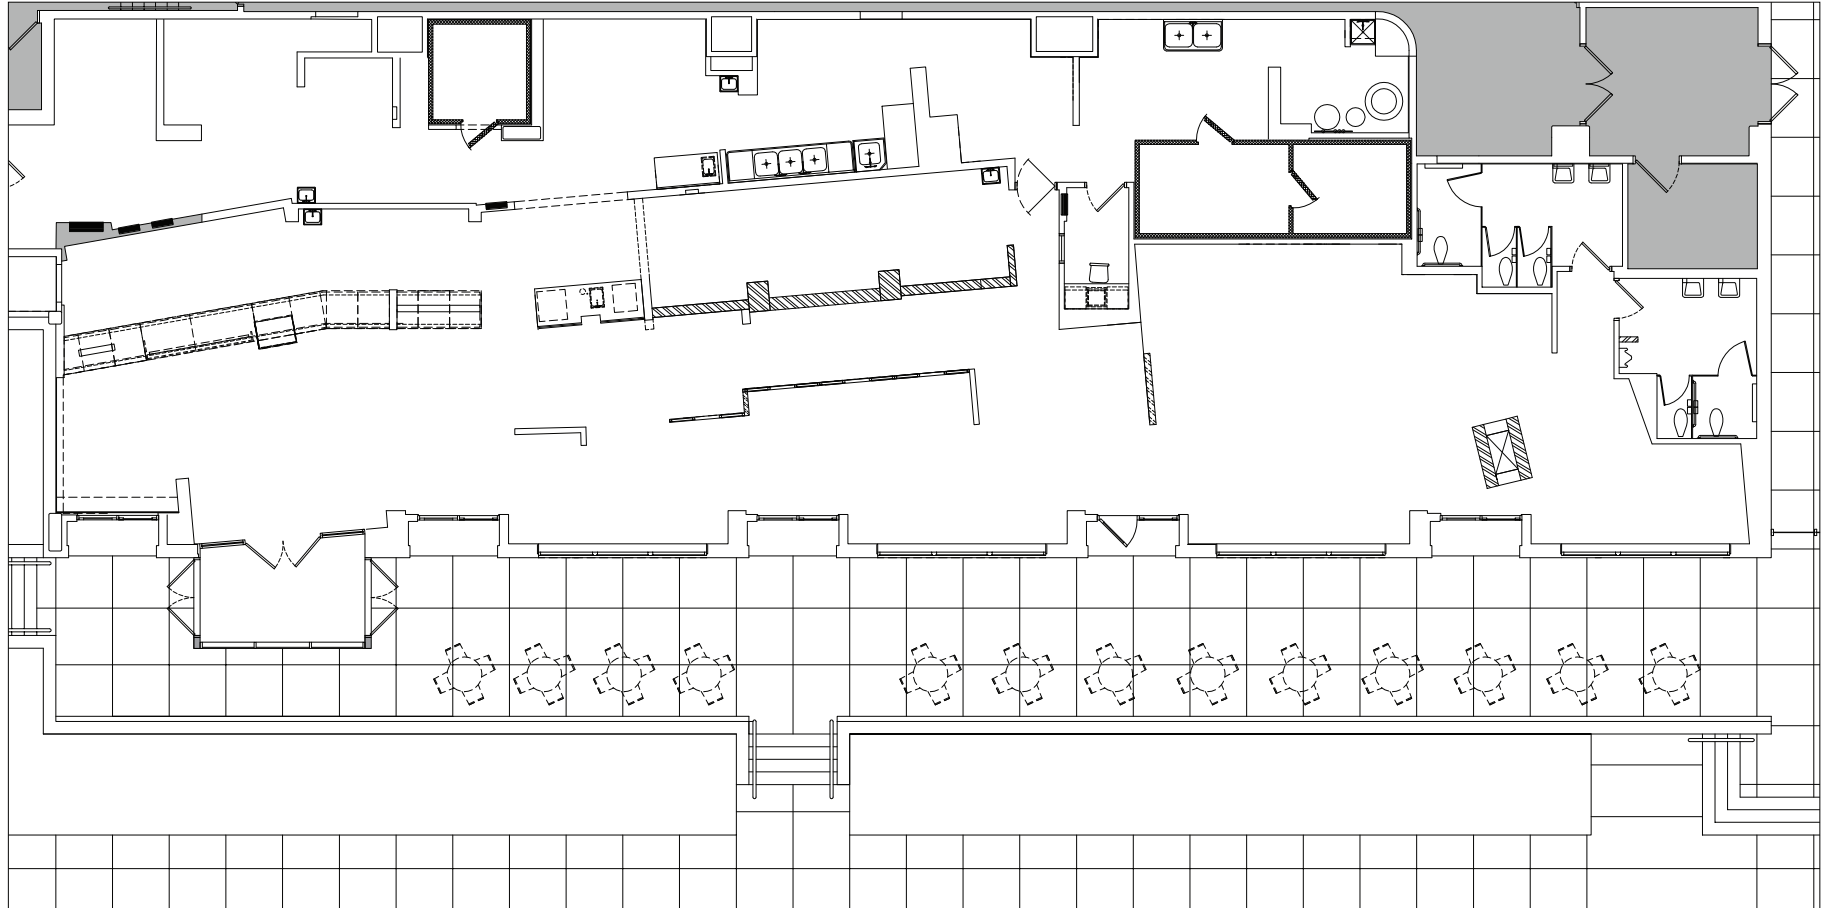

* Dimensions are Deemed
as Accurate but not to Scale

OWNED & MANAGED BY



LEASED BY

