


CIBC PLACE

Suite 500

As-Built 3,733 Sq. Ft.

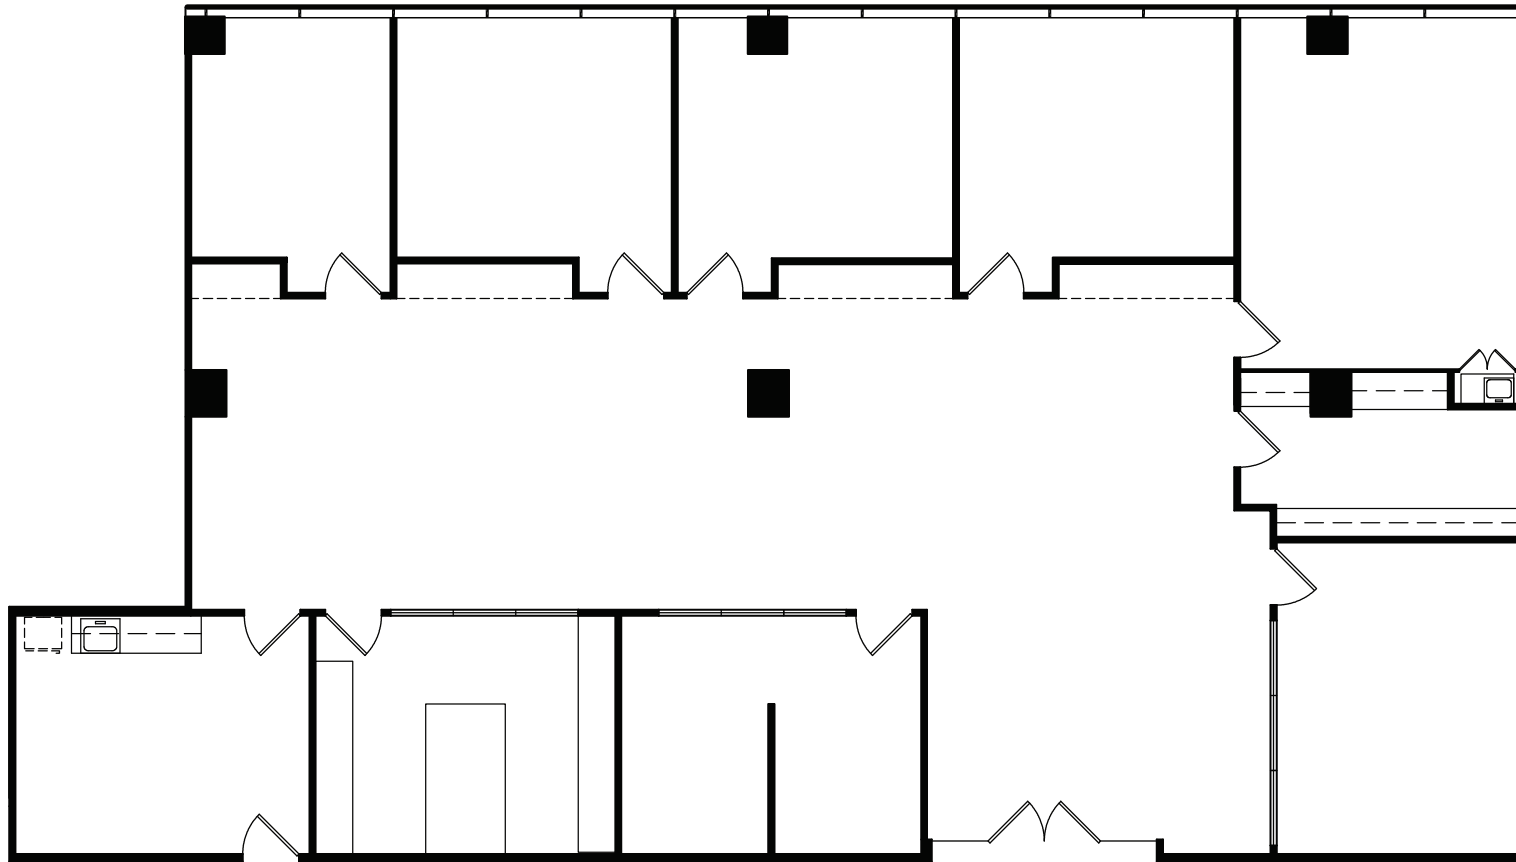

* Dimensions are Deemed as Accurate but not to Scale