


EDINBOROUGH

CORPORATE CENTER

Suite 500

As-Built 13,936 Sq. Ft.

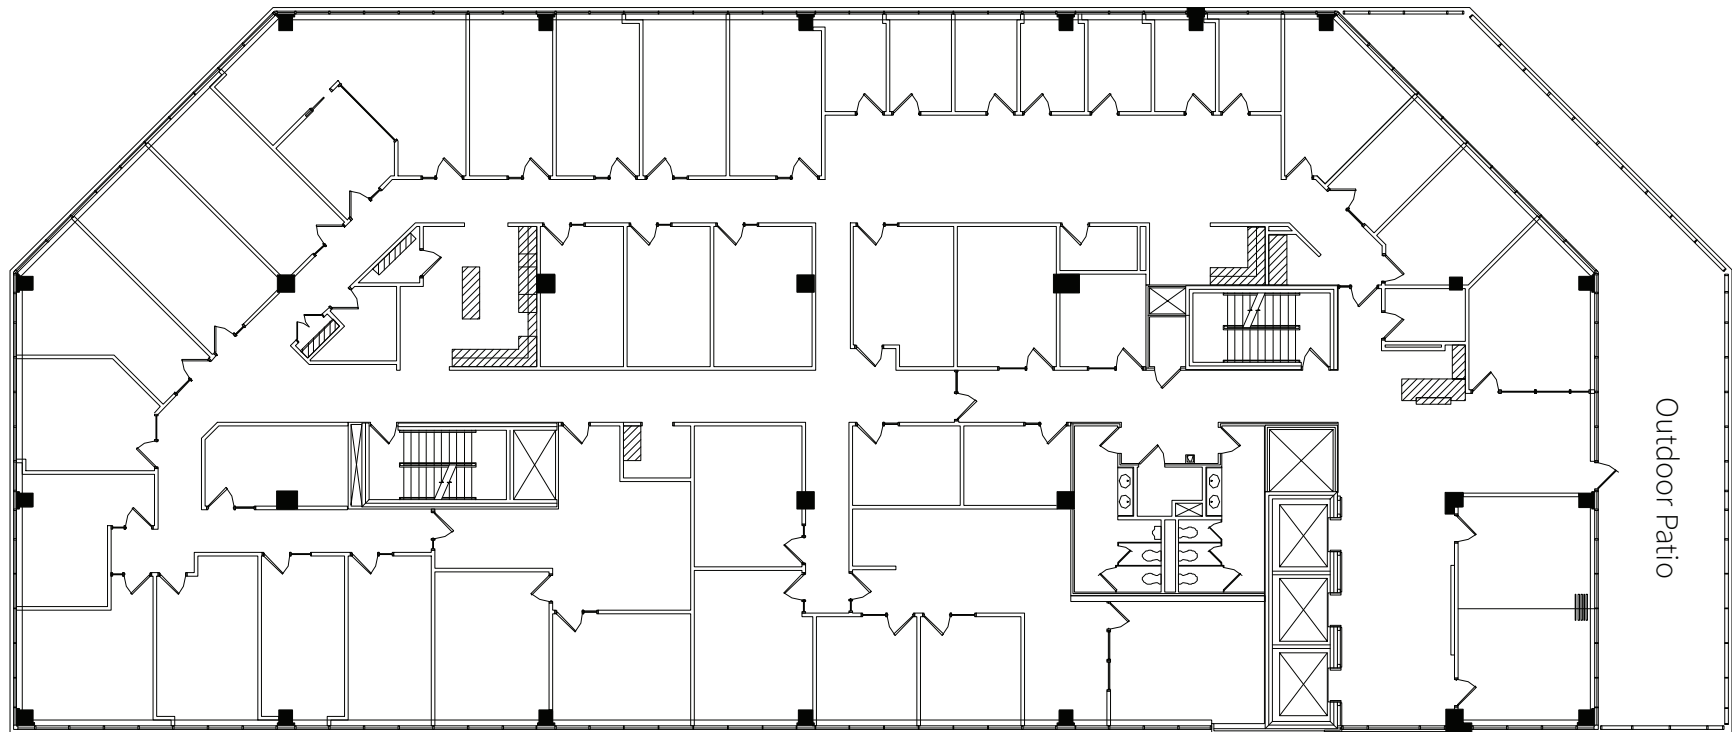

* Dimensions are Deemed
as Accurate but not to Scale

OWNED & MANAGED BY



LEASED BY

