


OLYMPIC PLACE

Suite 500

As-Built 12,941 Sq. Ft.

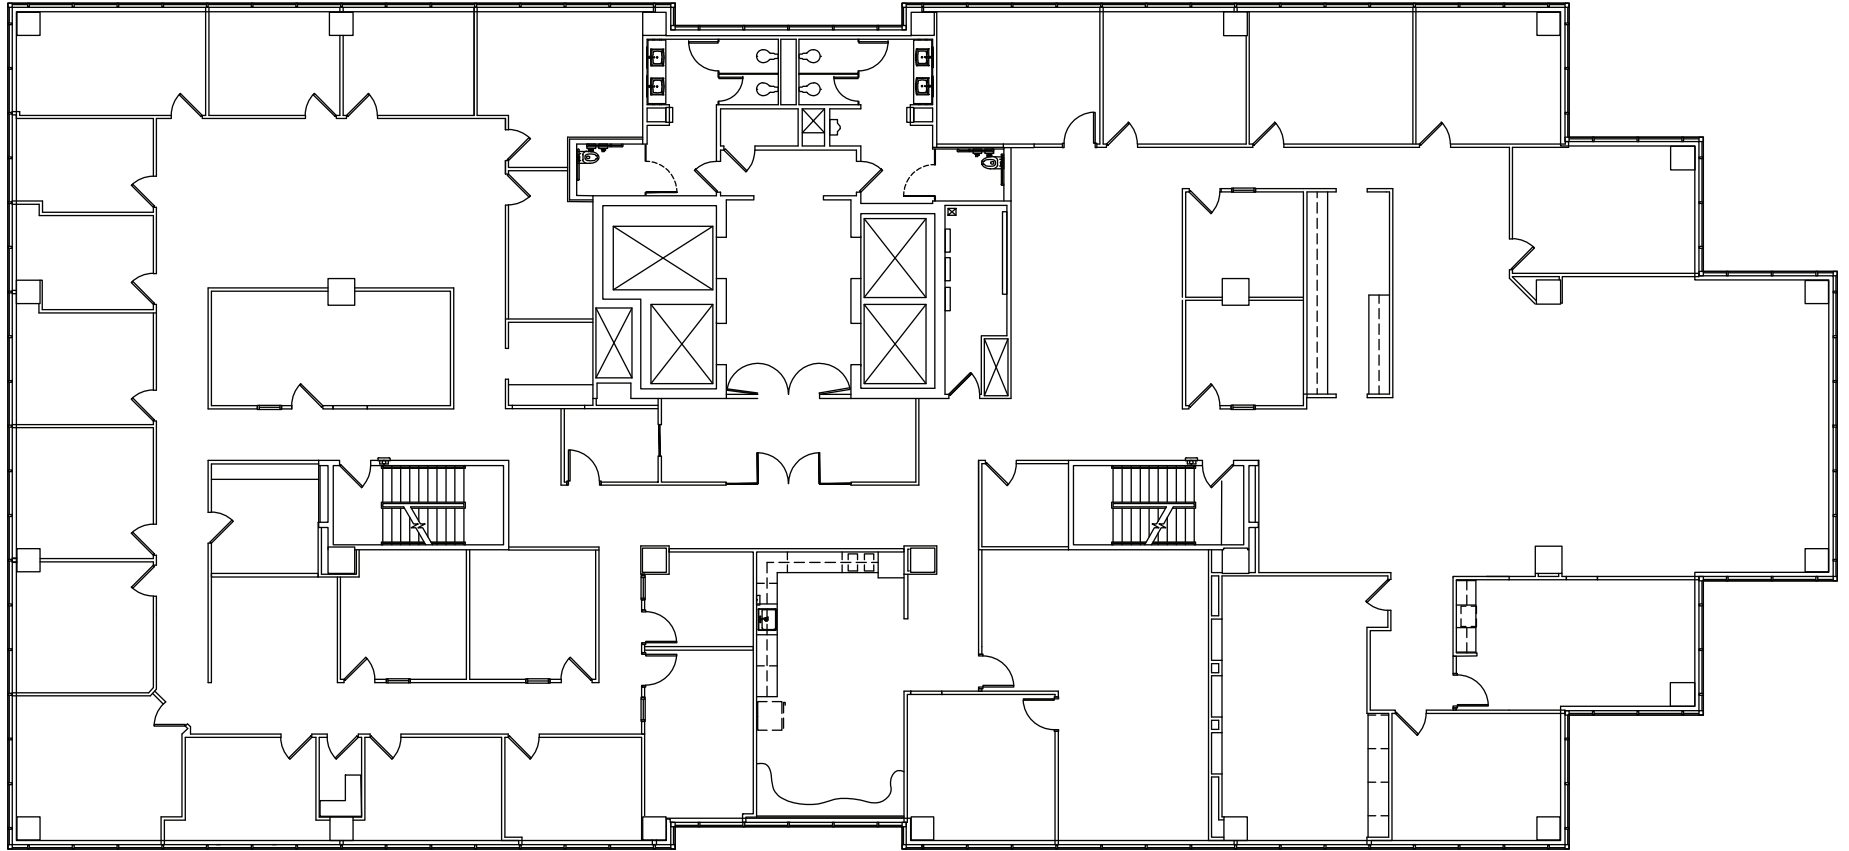

* Dimensions are Deemed as Accurate but not to Scale

OWNED & MANAGED BY



LEASED BY

