



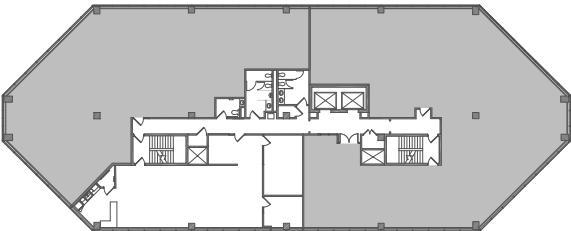

WEST RIDGE

Suite 510

As-Built 1,949 Sq. Ft.

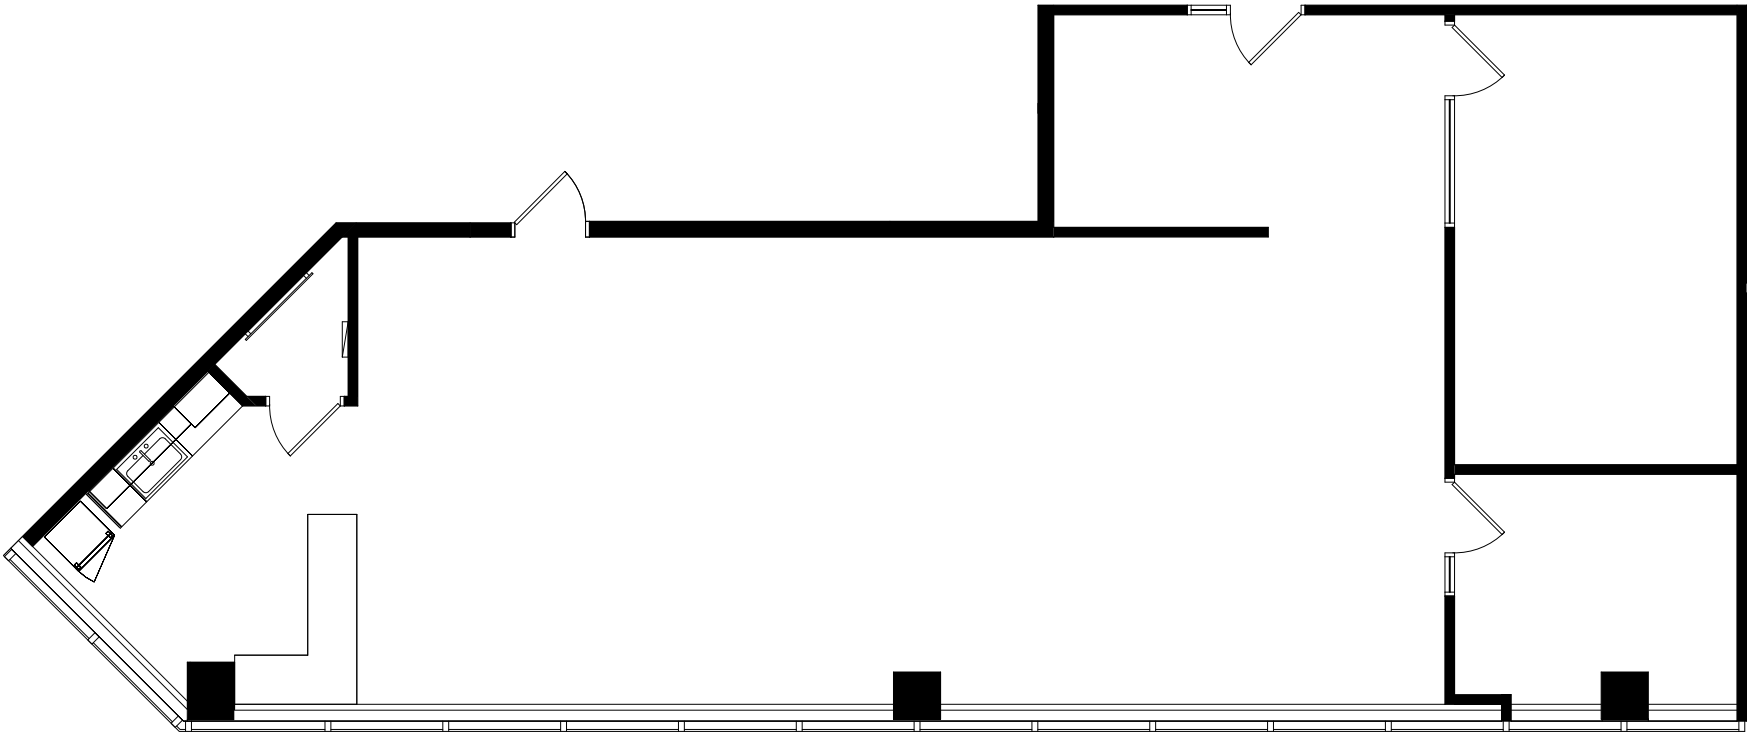

\* Dimensions are Deemed as Accurate but not to Scale

OWNED & MANAGED BY



LEASED BY

