


Suite 600

As-Built

31,596 Sq. Ft.

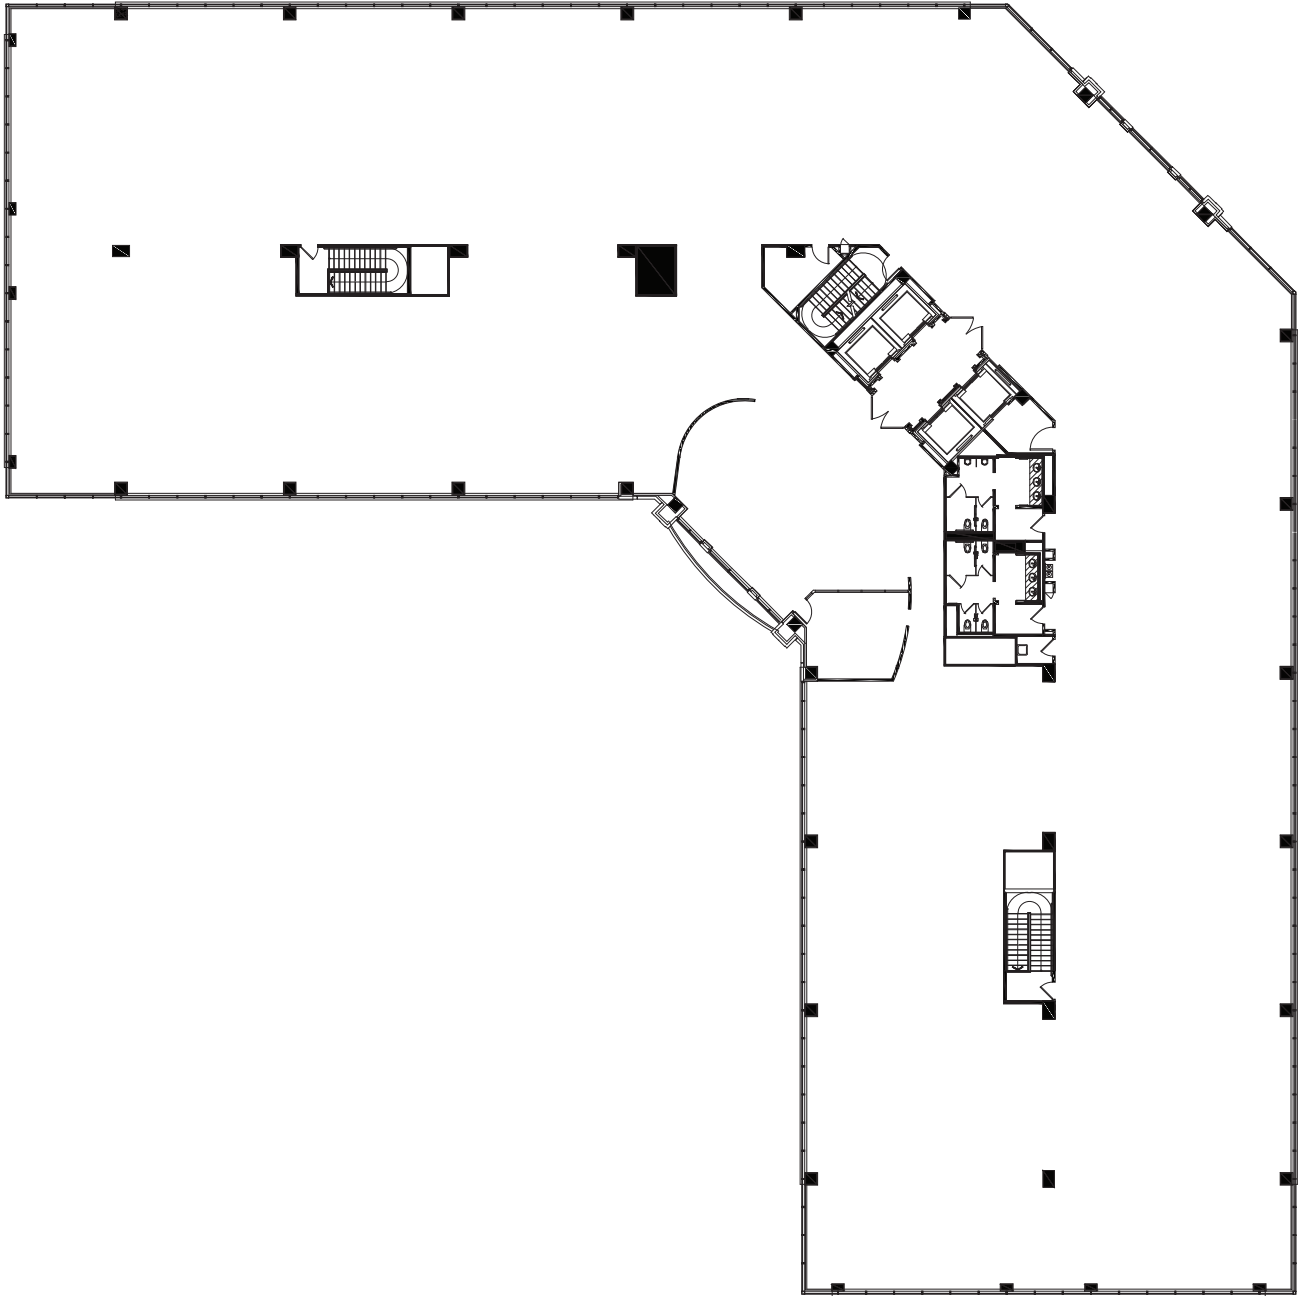

* Dimensions are Deemed
as Accurate but not to Scale

OWNED & MANAGED BY



LEASED BY

