
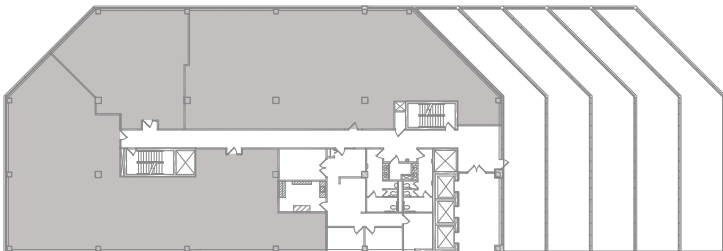


EDINBOROUGH

CORPORATE CENTER

Suite 601

As-Built 1,750 Sq. Ft.

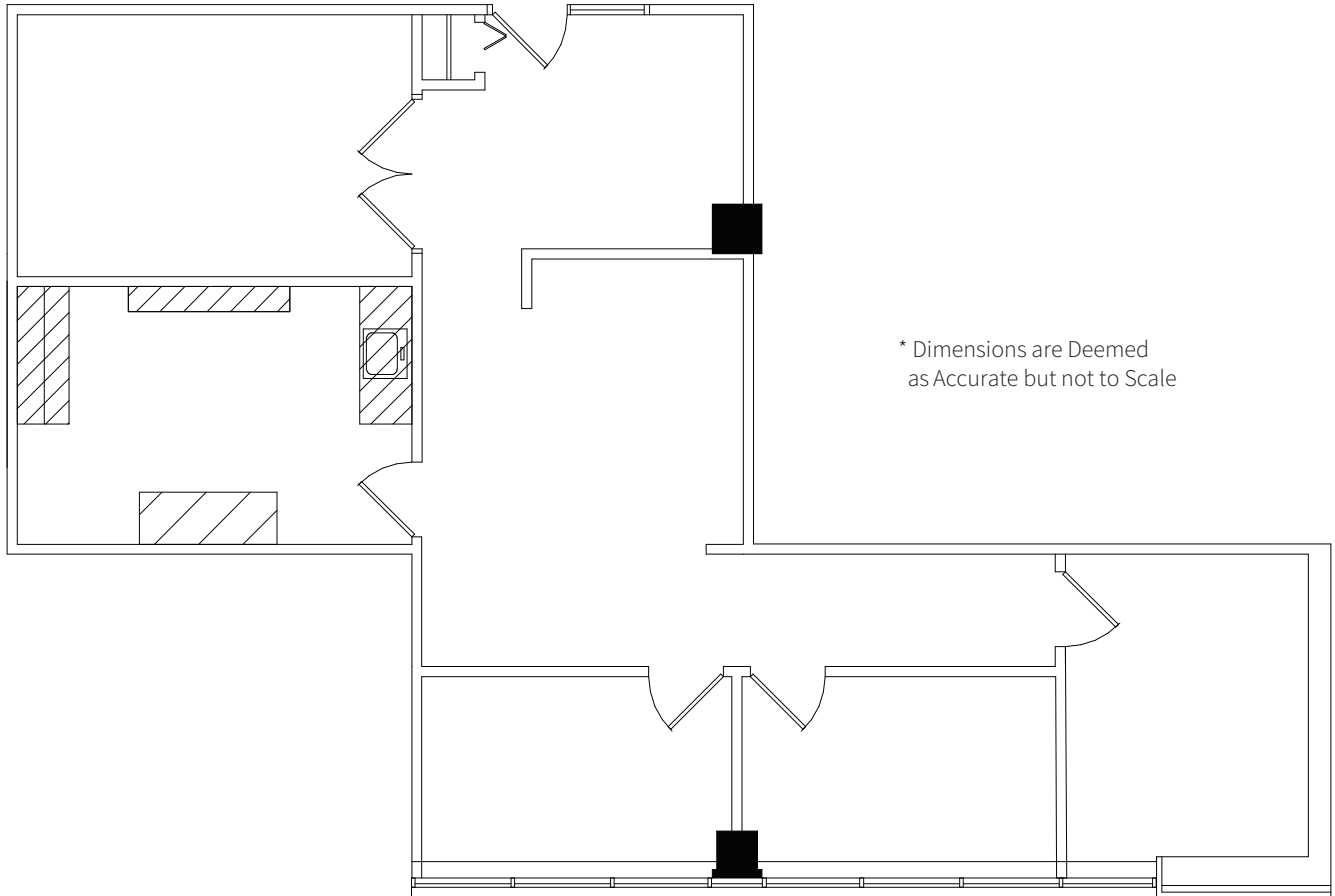

OWNED & MANAGED BY



LEASED BY

