


# EDINBURGH


CORPORATE CENTER

Suite 610

As-Built 4,583 Sq. Ft.

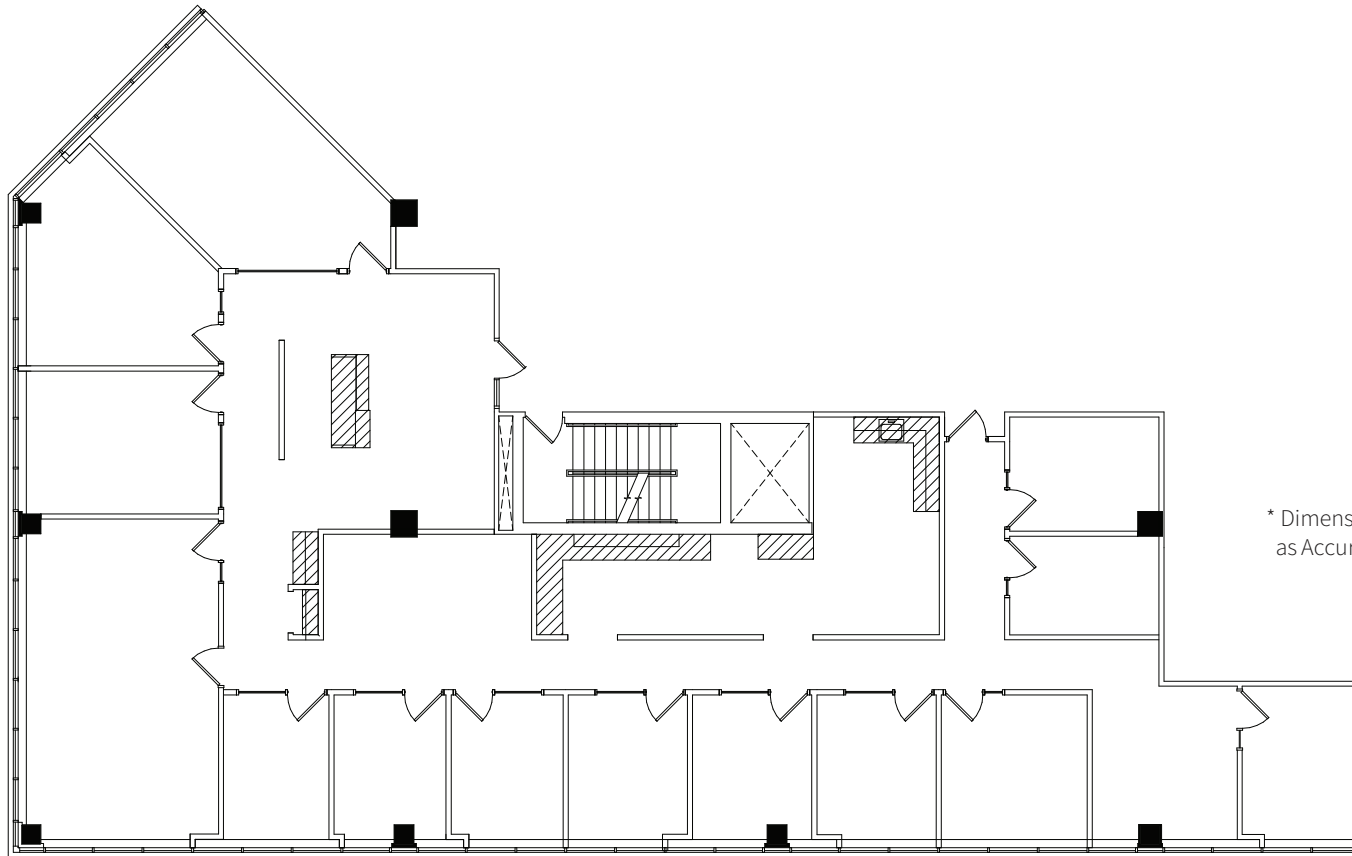

\* Dimensions are Deemed as Accurate but not to Scale

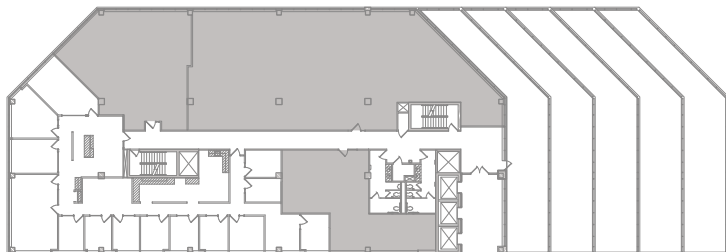

OWNED & MANAGED BY



LEASED BY

