


# EDINBURGH


CORPORATE CENTER

Suite 670

As-Built 3,210 Sq. Ft.

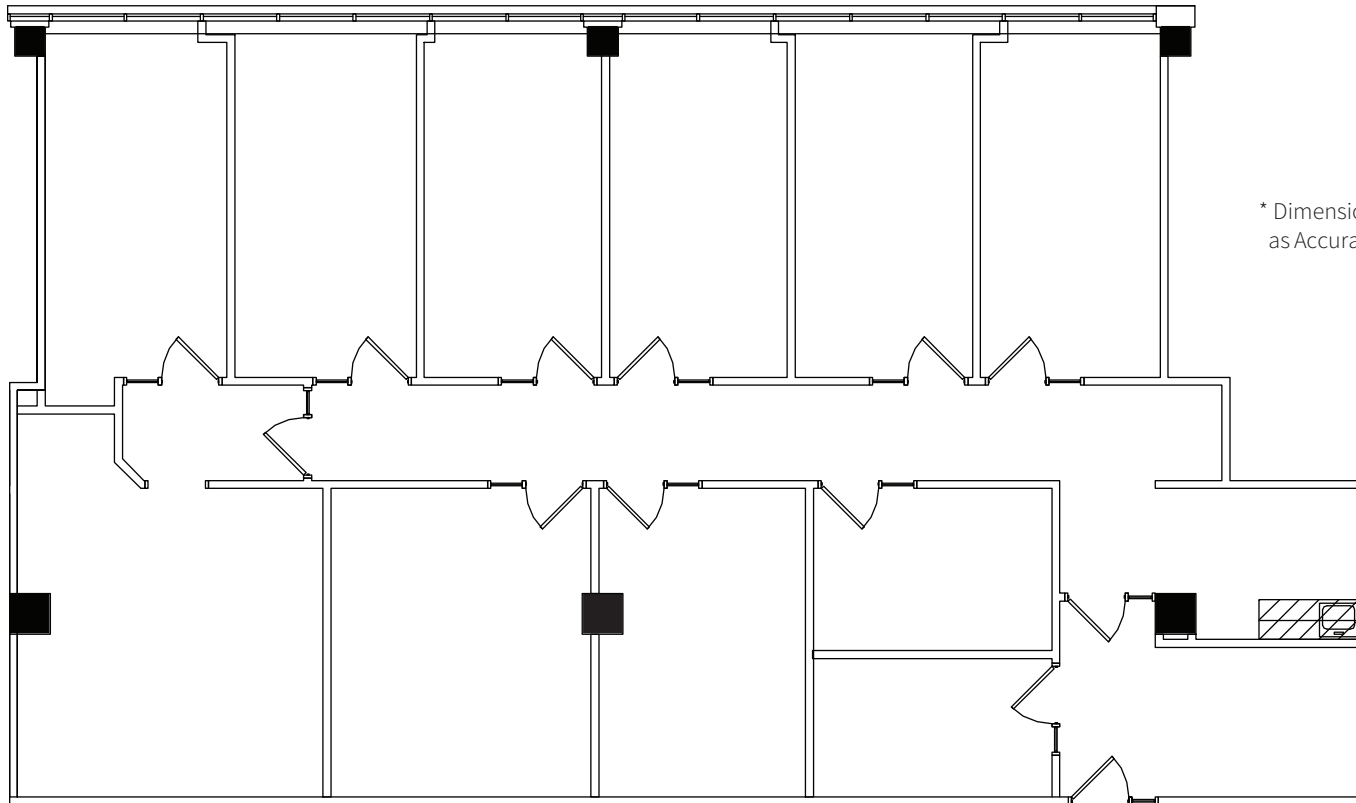

\* Dimensions are Deemed as Accurate but not to Scale

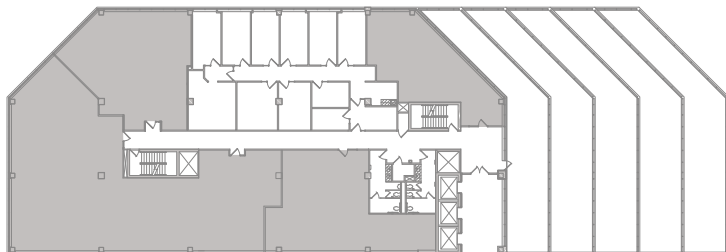

OWNED & MANAGED BY



LEASED BY

