


OLYMPIC PLACE


Suite 700

As-Built

7,547 Sq. Ft.

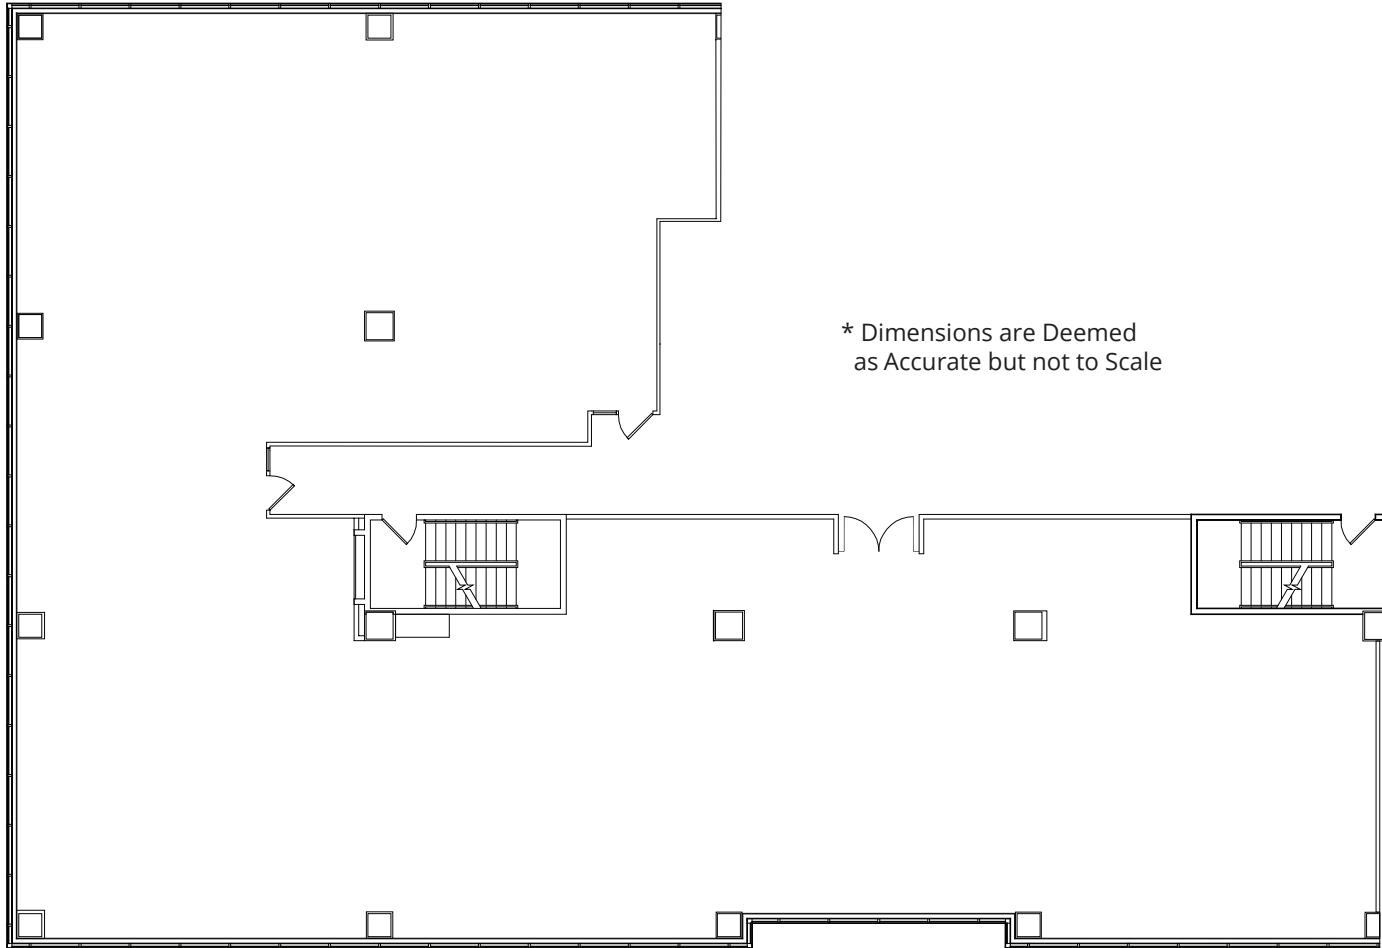

* Dimensions are Deemed
as Accurate but not to Scale

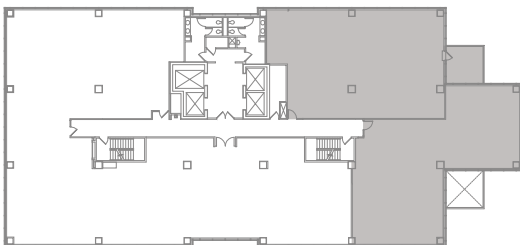

OWNED & MANAGED BY



LEASED BY

