


Suite 705

As-Built 1,347 Sq. Ft.

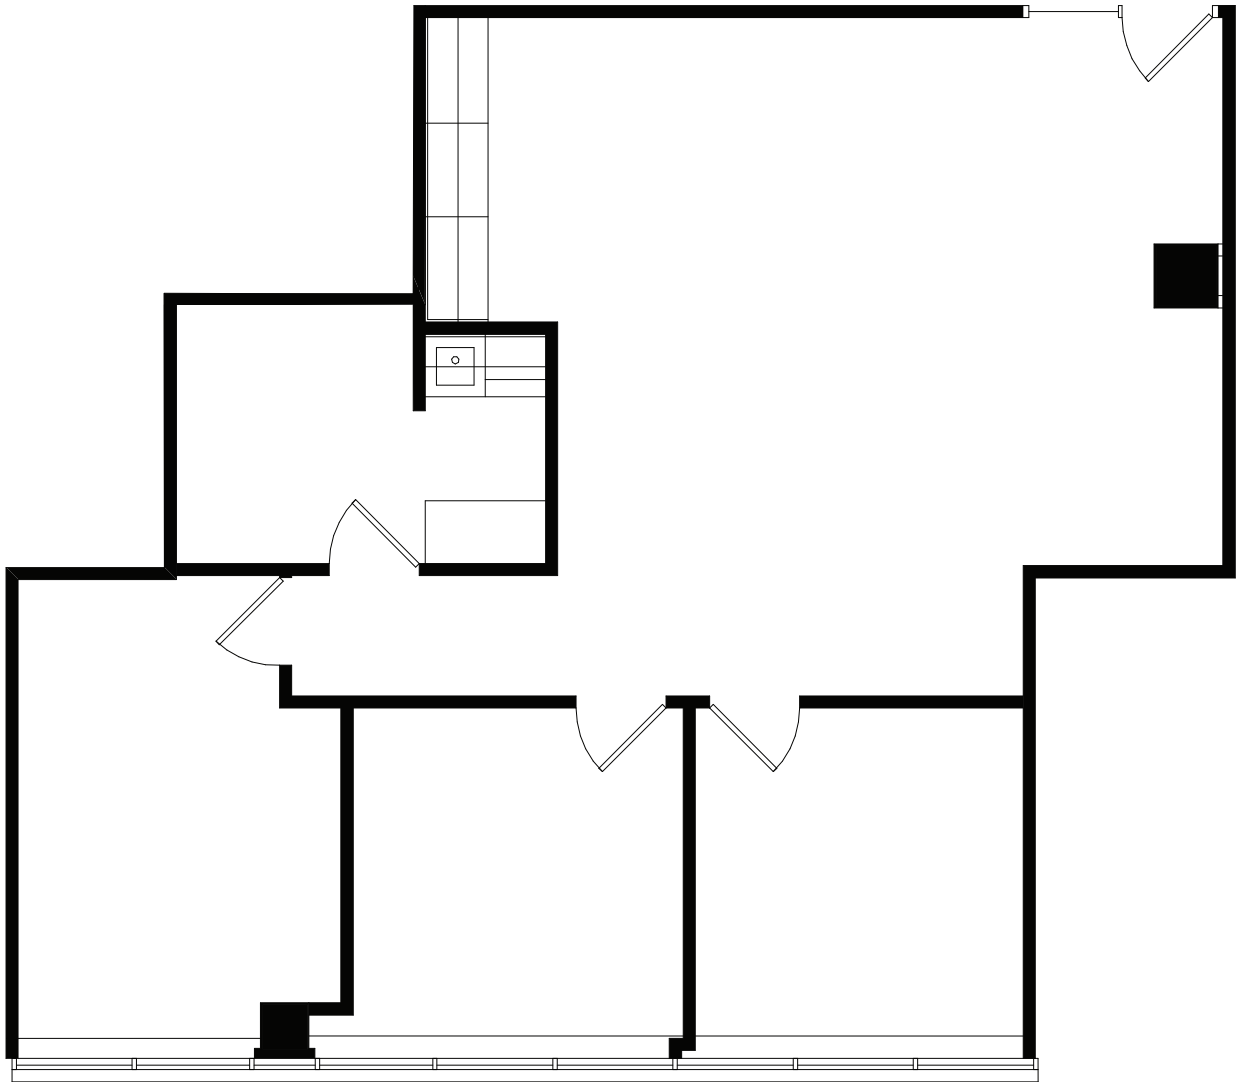

* Dimensions are Deemed as Accurate but not to Scale

