


CIBC PLACE

Suite 800

As-Built 1,620 Sq. Ft.

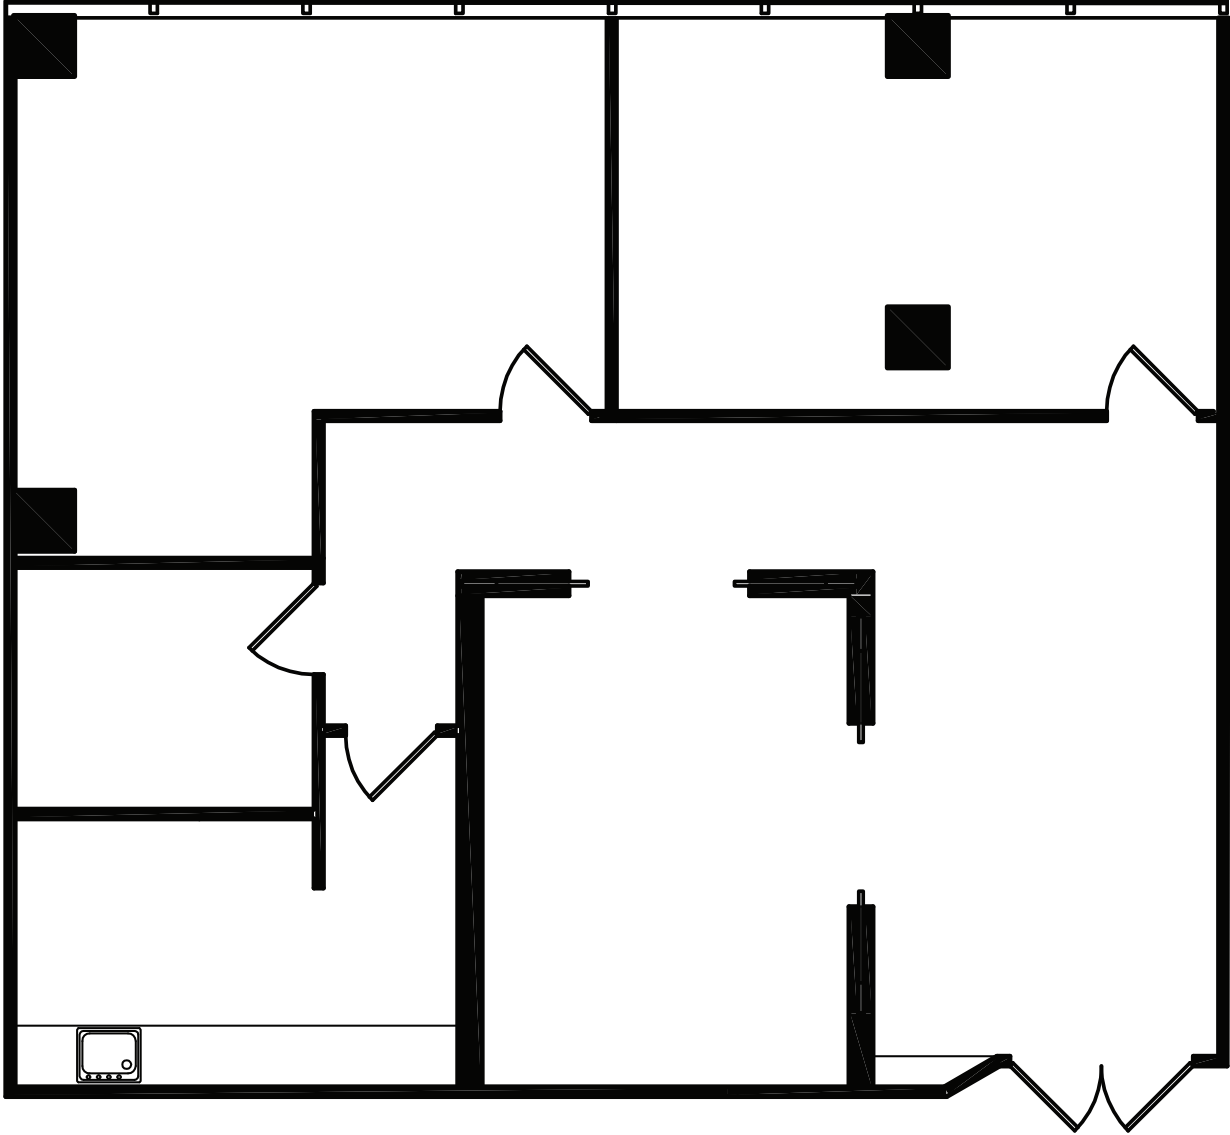

* Dimensions are Deemed as Accurate but not to Scale

