



OLYMPIC PLACE

Suite 810

As-Built 1,159 Sq. Ft.

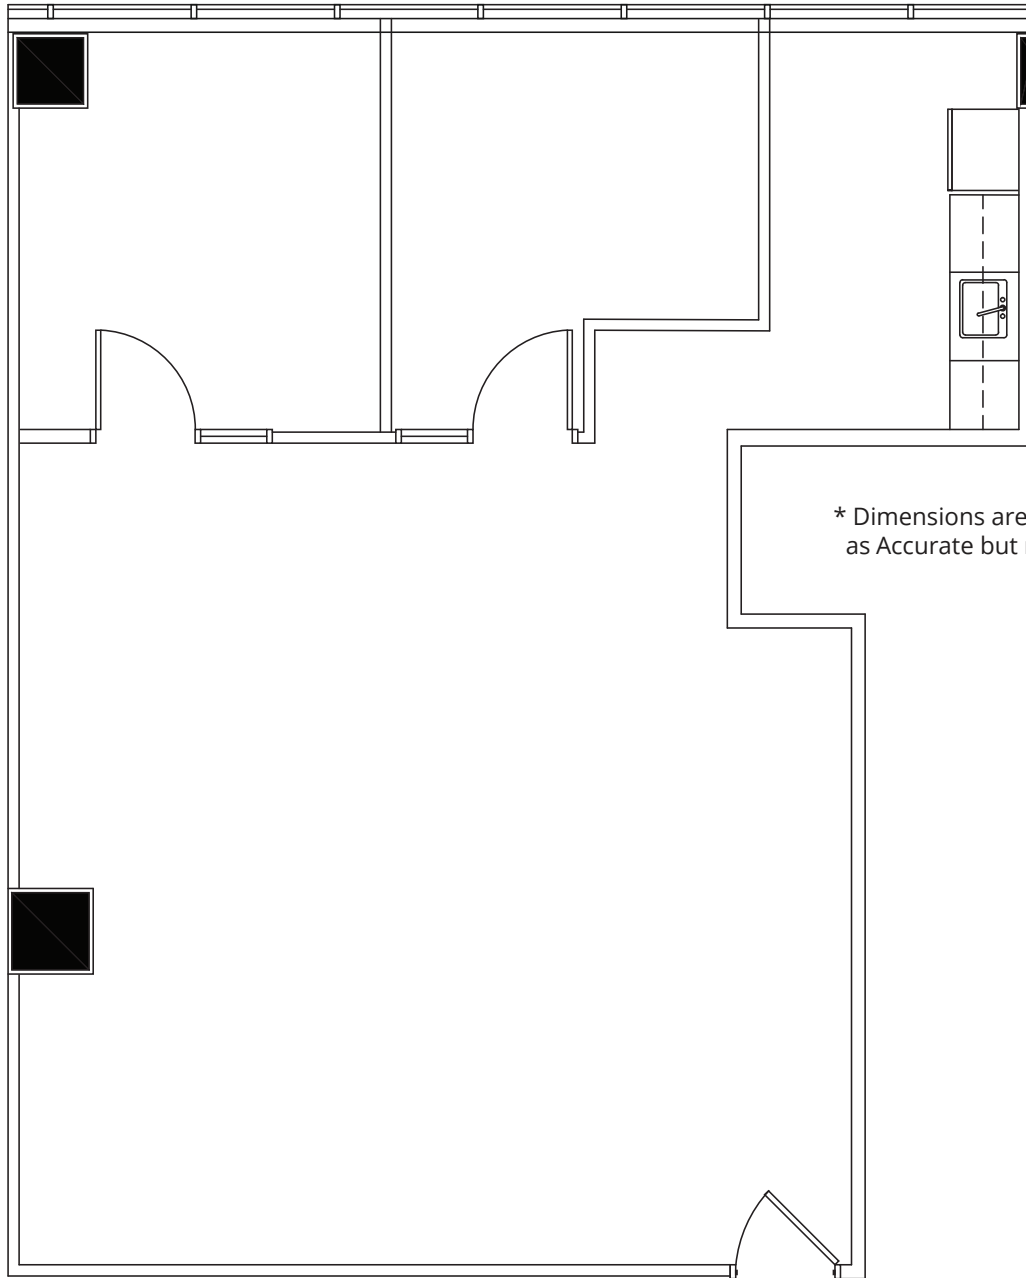

* Dimensions are Deemed as Accurate but not to Scale

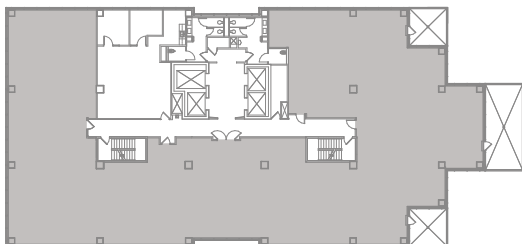

OWNED & MANAGED BY



LEASED BY

