
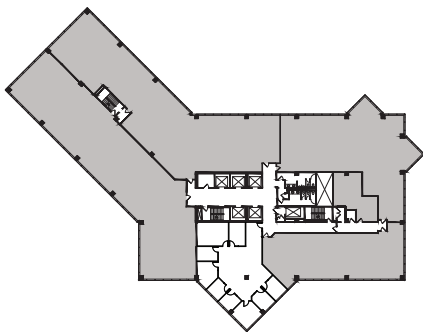


MINNESOTA CENTER

Suite 920

As-Built

2,630 Sq. Ft.

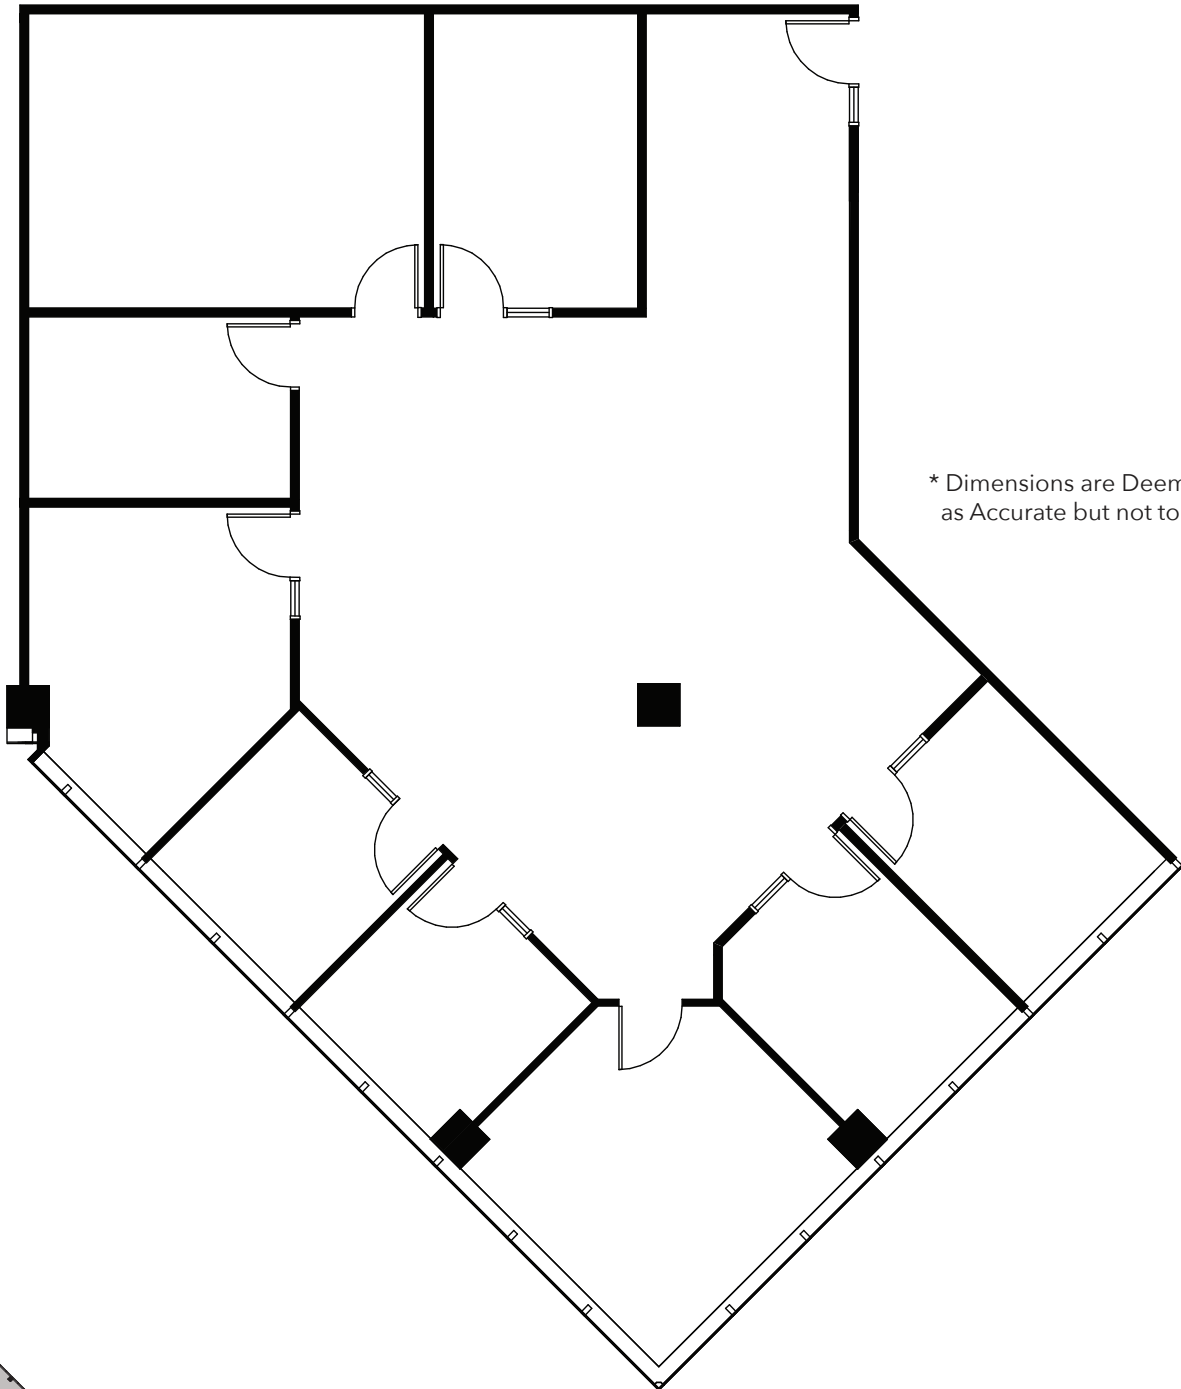

OWNED & MANAGED BY



LEASED BY

