
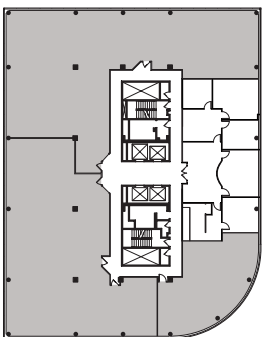


 **BEMISTON TOWER**

Suite 950

As-Built

2,505 Sq. Ft.

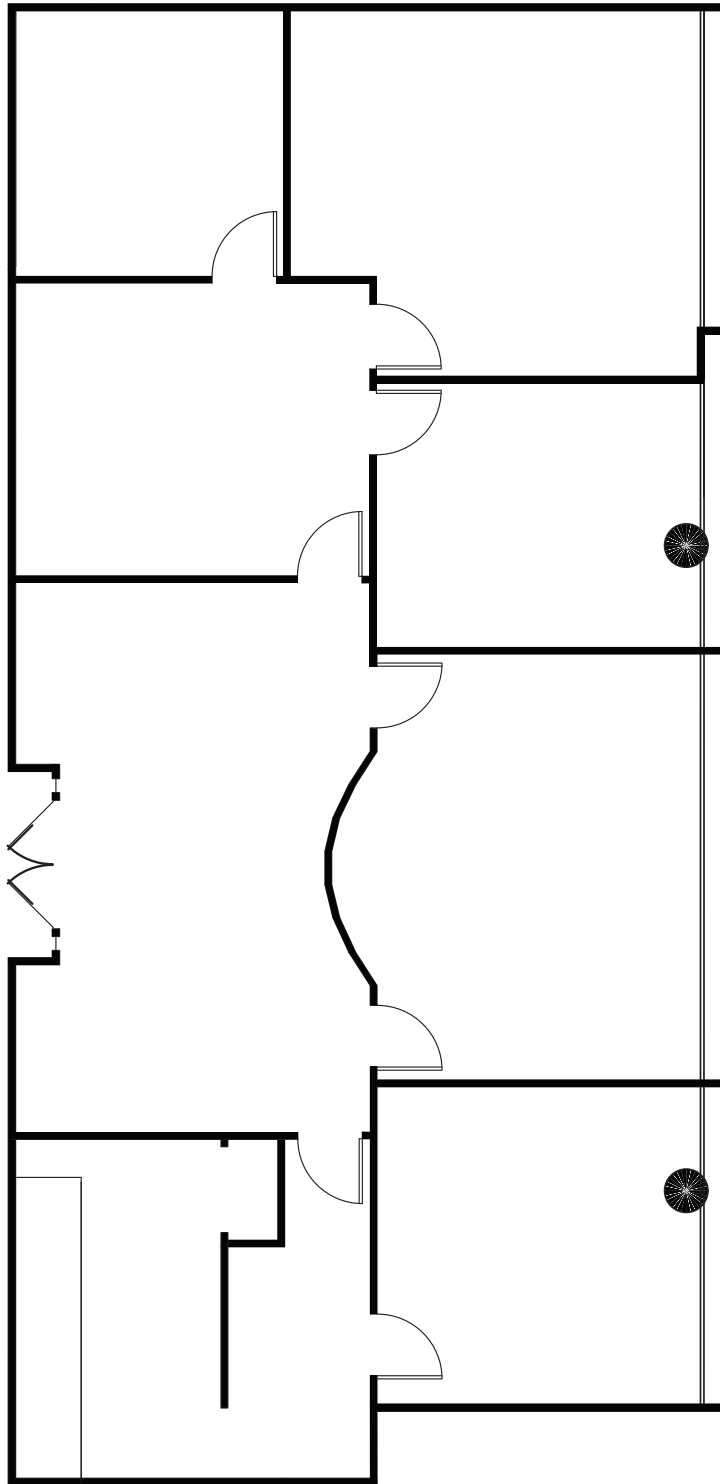

\* Dimensions are Deemed as Accurate but not to Scale

LEASED & MANAGED BY

