


West Park Retail

12613 Olive Blvd.

As-Built 2,315 Sq. Ft.

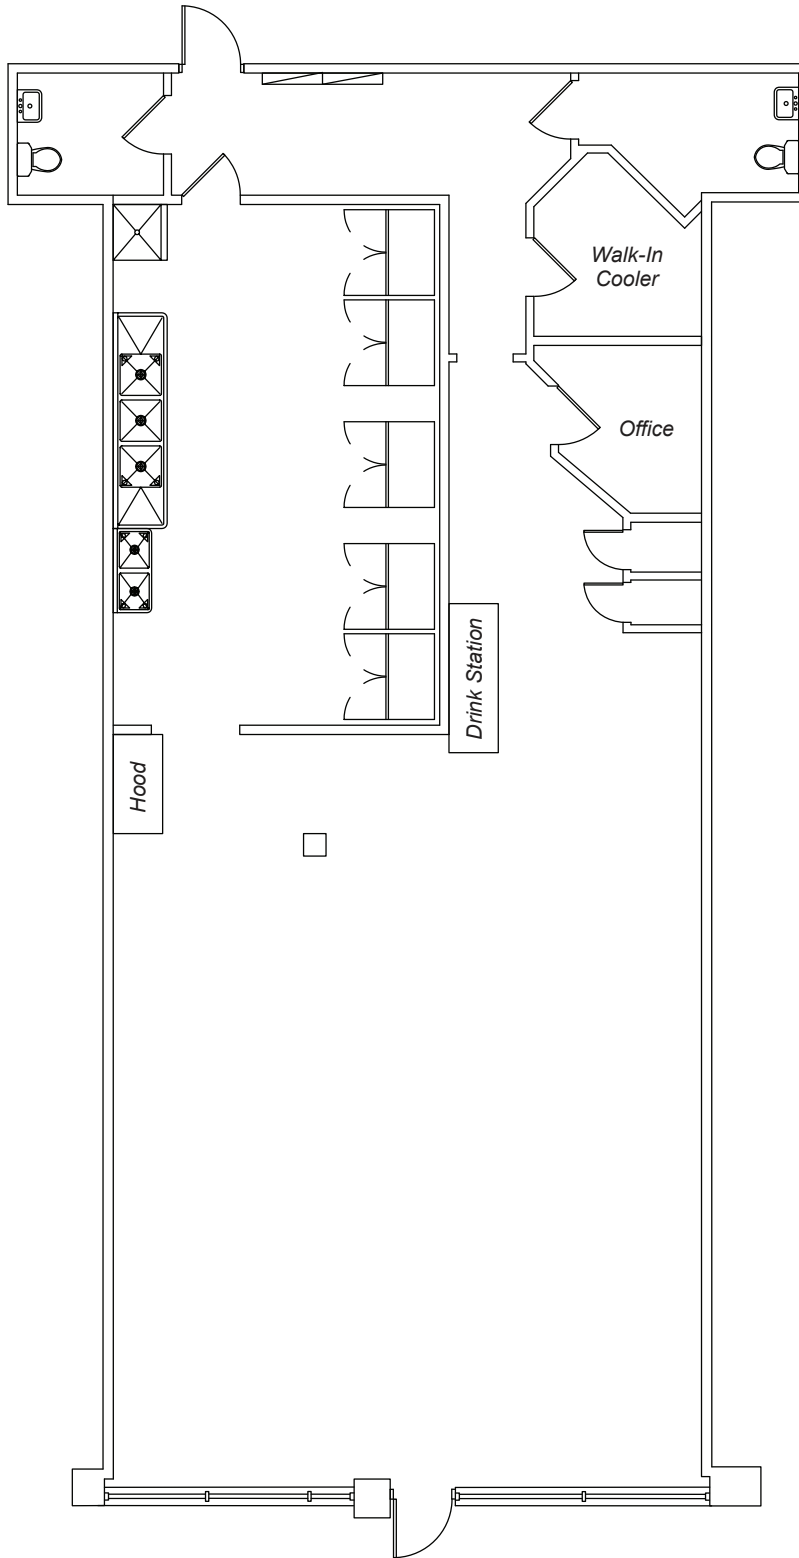

* Dimensions are Deemed as Accurate but not to Scale

