

MINNESOTA
CENTER

Suite 1010
As-Built 5,703 Sq. Ft.

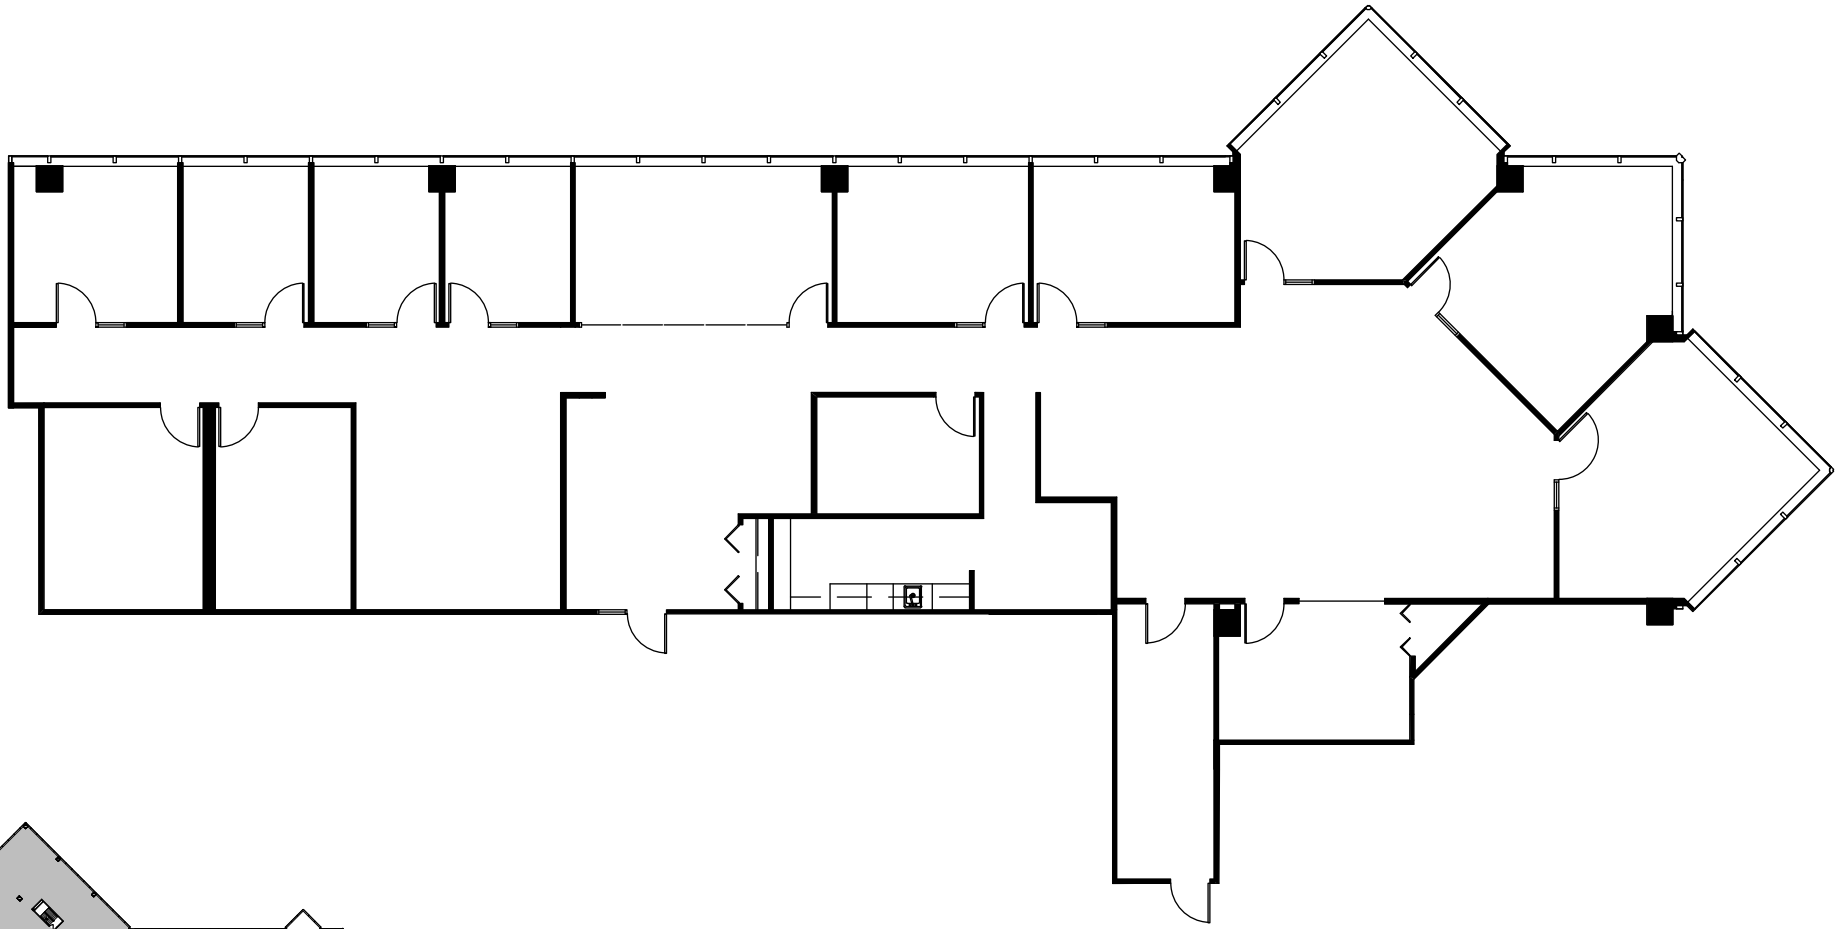

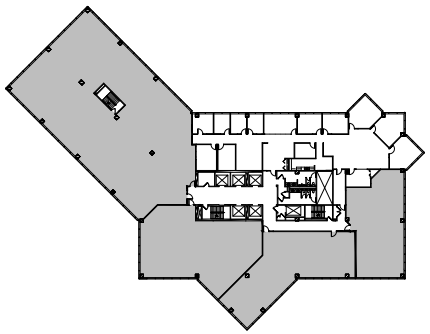

* Dimensions are Deemed
as Accurate but not to Scale

OWNED & MANAGED BY
ALTUS

LEASED BY
JLL