

MINNESOTA
CENTER

Suite 1040
As-Built 2,265 Sq. Ft.

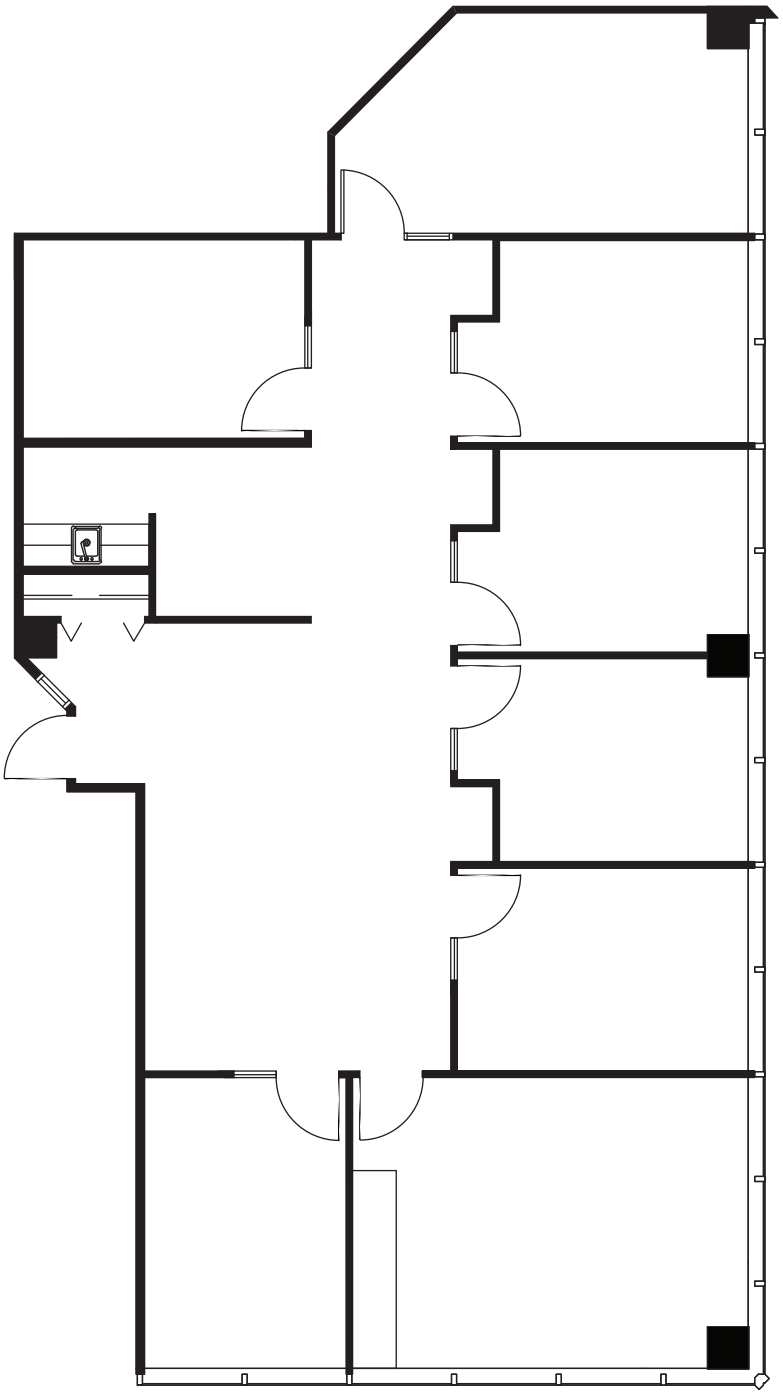

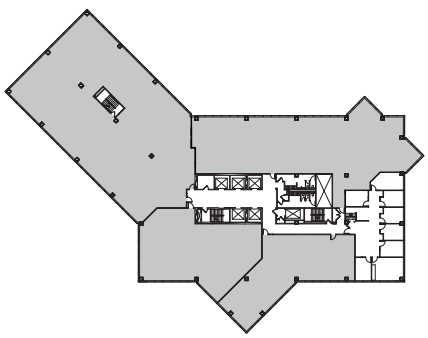

* Dimensions are Deemed as Accurate but not to Scale

OWNED & MANAGED BY
ALTUS

LEASED BY
JLL®