

MINNESOTA
CENTER

Suite 810
As-Built 4,263 Sq. Ft.

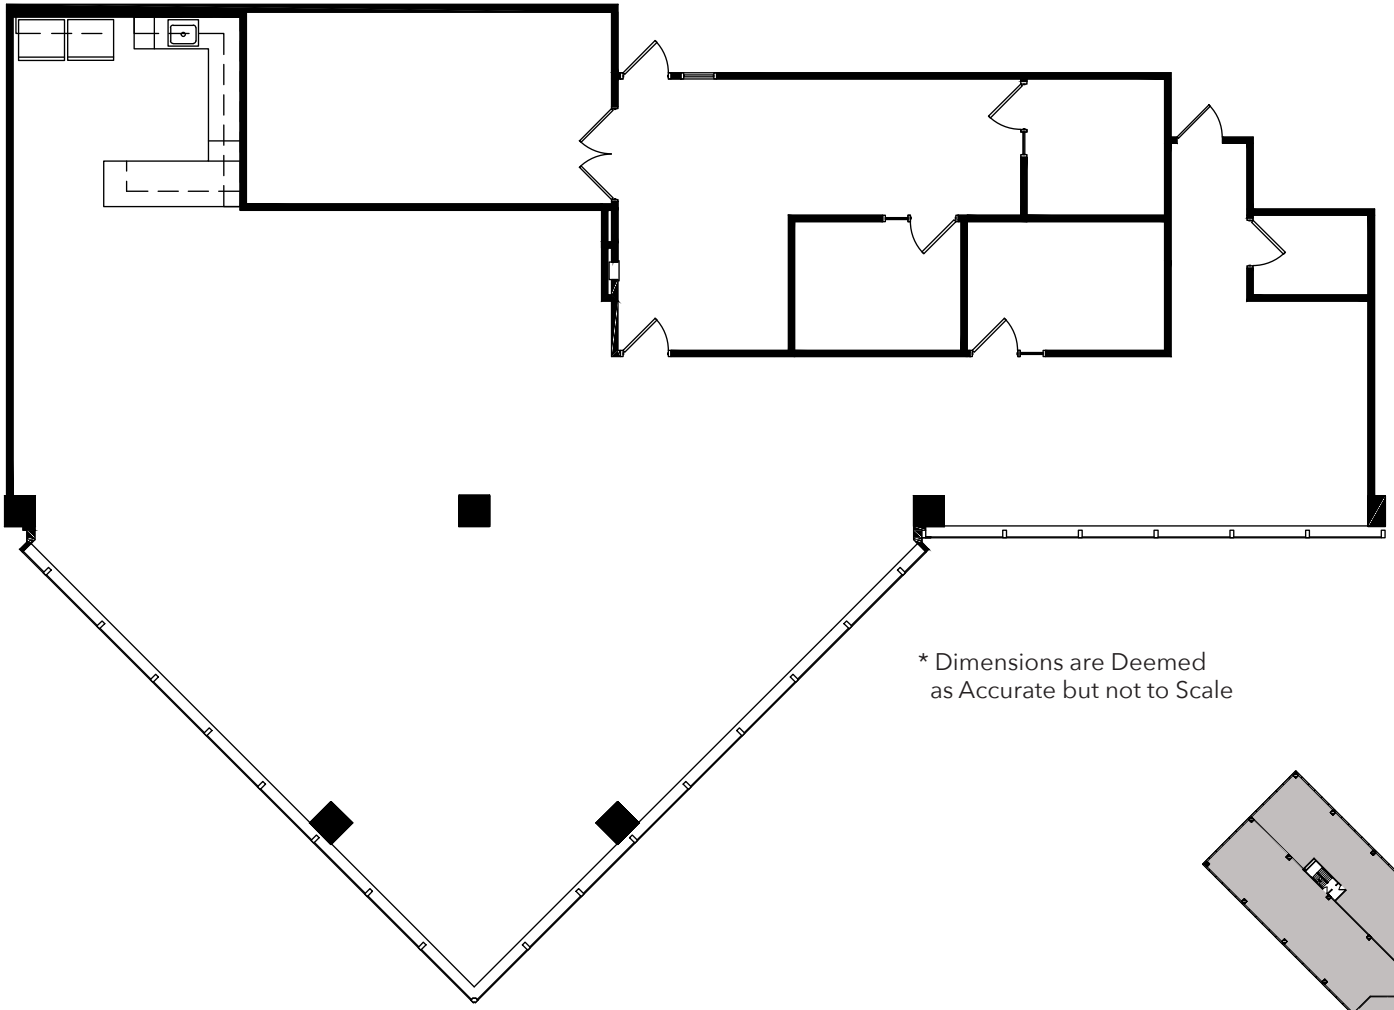

* Dimensions are Deemed
as Accurate but not to Scale

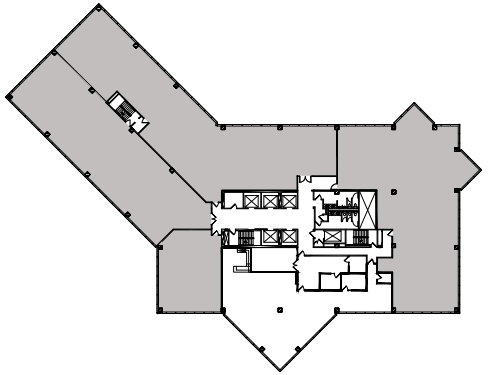

OWNED & MANAGED BY
ALTUS

LEASED BY
JLL